


T. 35 S., R. 1 E., W.M.



DIVERSION IS 1820 FEET SOUTH AND 770 FEET WEST OF THE NE CORNER OF SECTION 33.

△
HOLE IN MEADOW

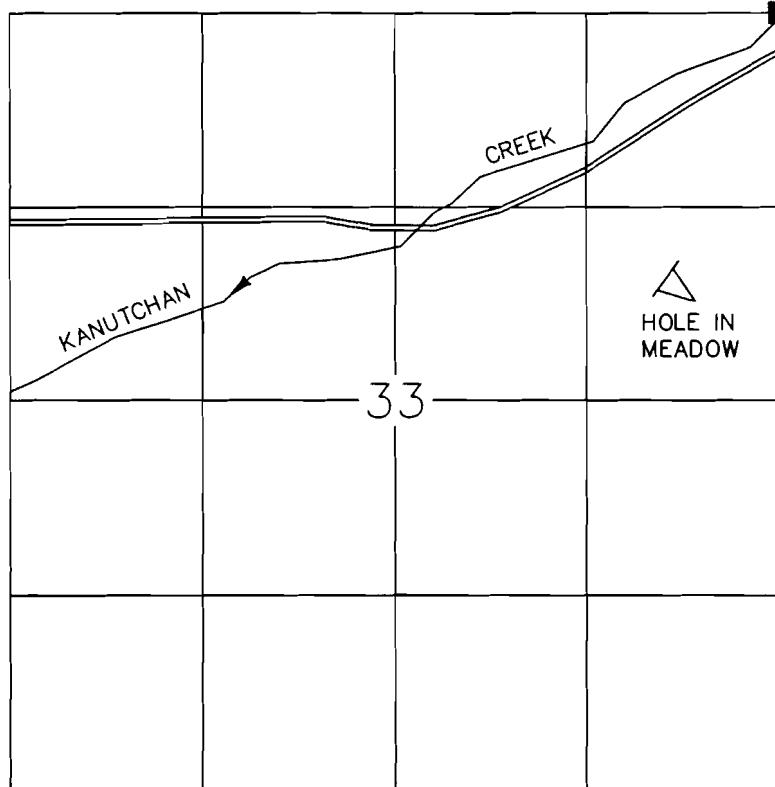

1" = 1320'


FINAL PROOF MAP

IN NAME OF

UNITED STATES BUREAU OF LAND MANAGEMENT

APPLICATION NO. R-83310

PERMIT NO. R-12418

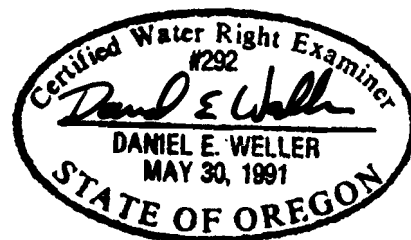

EXPIRES 6/30/00

SURVEYED: JUNE 9, 1999

THE PURPOSE OF THIS MAP IS FOR IDENTIFYING THE LOCATION OF THE WATER RIGHT ONLY AND IS NOT INTENDED TO PROVIDE LEGAL DIMENSIONS OR LOCATION OF PROPERTY OWNERSHIP LINES.

U.S. BUREAU OF LAND MANAGEMENT-OSO
BRANCH OF CADASTRAL SURVEY

DWG: HOLEMEAD

EXECUTED BY:
DANIEL E. WELLER, PLS, CWRE
P.O. BOX 2965
PORTLAND, OREGON 97208