


T. 38 S., R. 3 W., W.M.

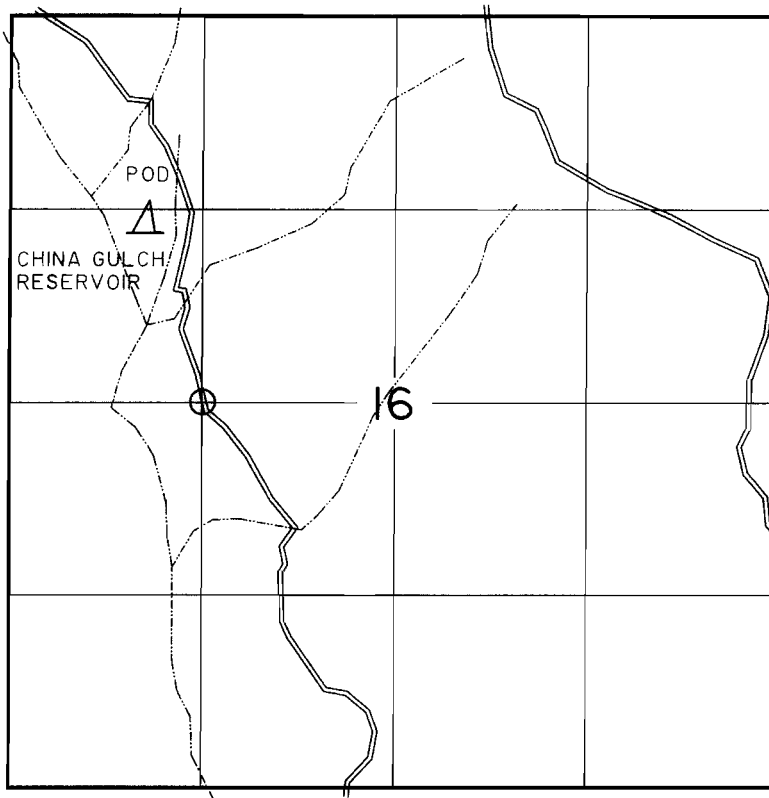

DIVERSION IS LOCATED
1160 FT. NORTH AND
415 FT. WEST OF THE
CENTER W1/16 COR. OF
SECTION 16.



1" = 1320'


CLAIM OF BENEFICIAL USE MAP

IN NAME OF

UNITED STATES BUREAU OF LAND MANAGEMENT

APPLICATION NO. ~~R-83300~~ AND S-83932

PERMIT NO. R-12653 AND 53563

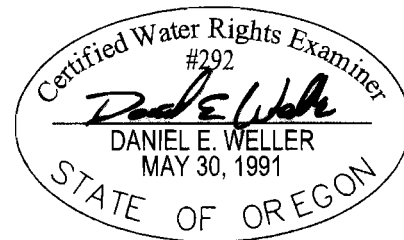

EXPIRES: JUNE 30, 2004

SURVEYED: MAY 8, 2001

THE PURPOSE OF THIS MAP IS FOR IDENTIFYING THE LOCATION OF THE WATER RIGHT ONLY AND IS NOT INTENDED TO PROVIDE LEGAL DIMENSIONS OR LOCATION OF PROPERTY OWNERSHIP LINES.

BLM PROJECT NO.

U.S. BUREAU OF LAND MANAGEMENT-OSO
BRANCH OF CADASTRAL SURVEY
DWG: CHINA 2

EXECUTED BY:
DANIEL E. WELLER, PLS, CWRE #292
P.O. BOX 10226
EUGENE, OREGON 97440