
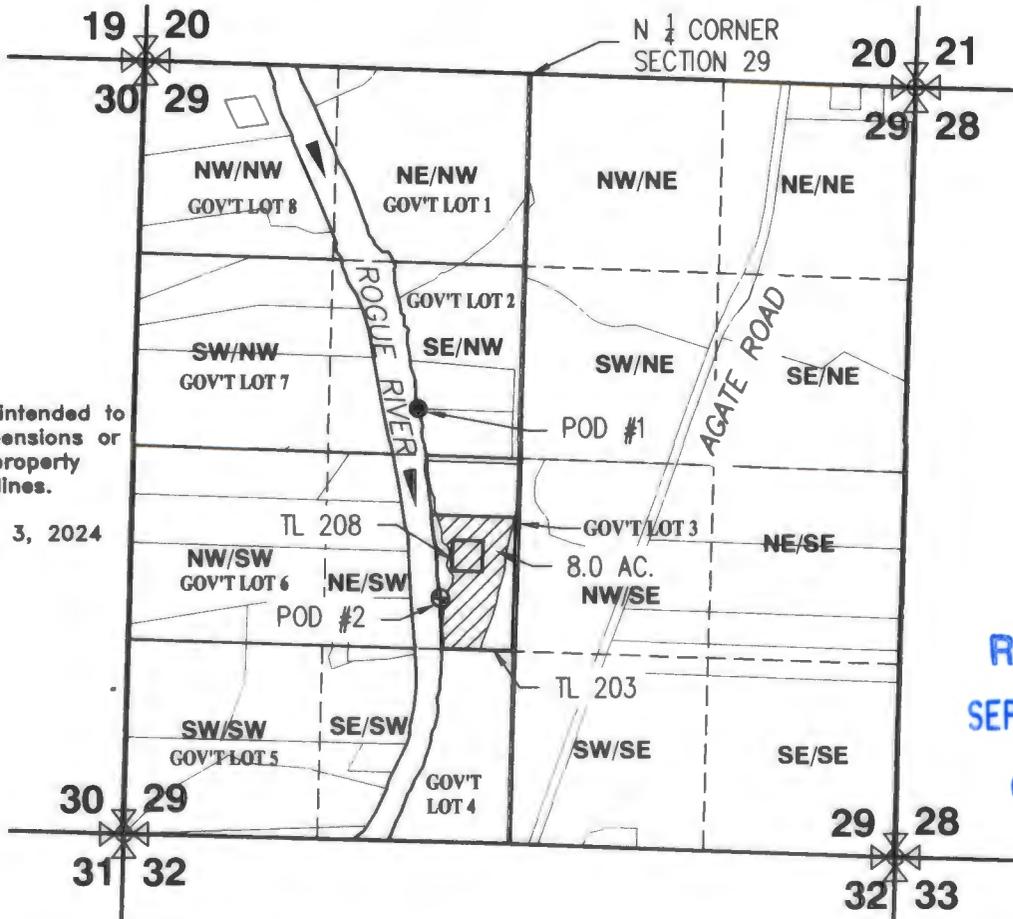


CLAIM OF BENEFICIAL USE MAP

TRANSFER: T-12966
 ADDITIONAL POINT OF DIVERSION

FOR
 JAMIE ERLICHT
 10208 BRIARWOOD DRIVE
 LOS ANGELES, CA 90077

SITUATED IN
 SECTION 29, TOWNSHIP 35 SOUTH, RANGE 1 WEST, W.M.
 JACKSON COUNTY, OREGON

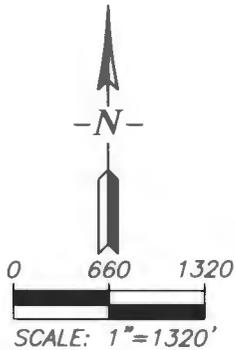

This map is not intended to provide legal dimensions or locations of property ownership lines.


EHM-September 3, 2024

Received
 SEP 13 2024
 OWRD

LEGEND

- POD #1 (ORIGINAL POINT OF DIVERSION, NOT TO BE USED) 2300' SOUTH AND 680' WEST OF NORTH QUARTER CORNER SECTION 29
- ⊕ POD #2 (POINT OF DIVERSION IN USE) FISH SCREEN, PUMP AND METER LOCATED AT BANK OF RIVER. 3600' SOUTH AND 632' WEST OF NORTH QUARTER CORNER SECTION 29

- PLACE OF USE - IRRIGATION
- 1/4-1/4 SECTION LINE

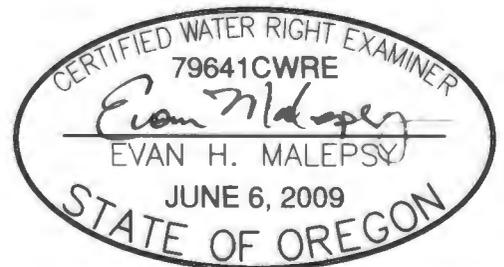

RENEWS: 12/31/2024

ROGUE CIVIL LLC
 emalepsy@roguecivil.com 541-621-2868