


CLAIM OF BENEFICIAL USE MAP

UNDER APPLICATION R-82529; PERMIT R-12361


GOV'T. LOT 1 SEC 3 T 41S R 38E W.M.

U.S.G.S. QUD - CHICKEN SPRING, OREG. - 7 1/2'

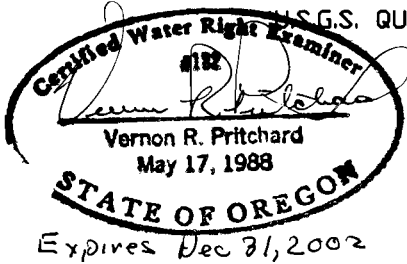

LEGEND

- ◊ RESERVOIR
- ==== ROAD
- - - - CHANNEL
- ◆ FD SEC COR
- . - . DISTRICT BOUNDARY
- ~ SPRING
- x - FENCE

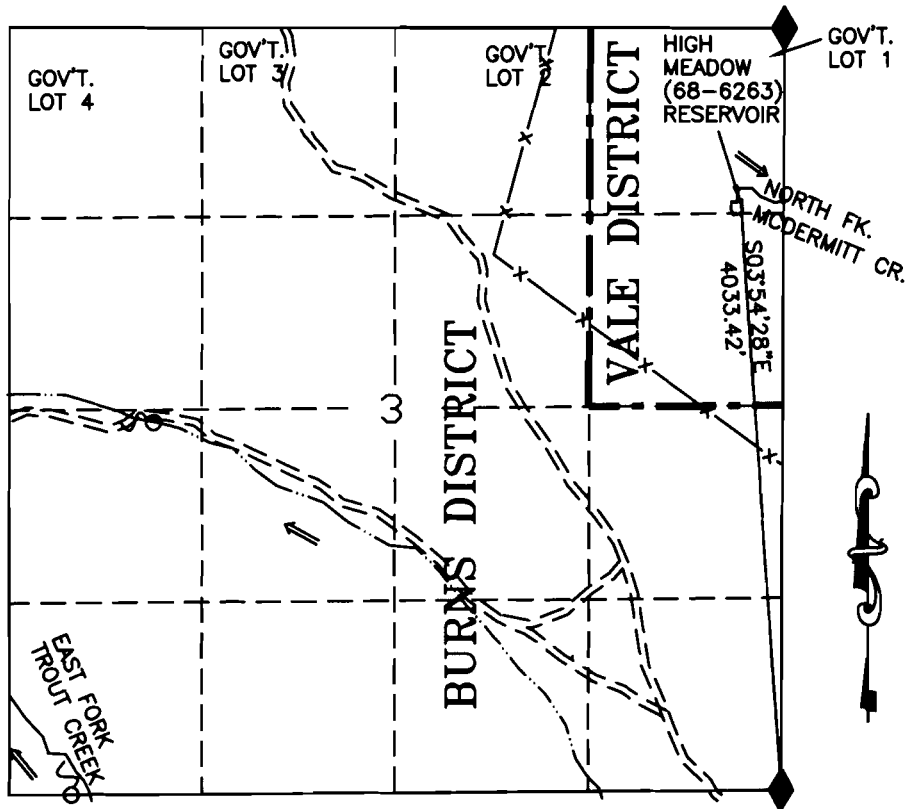


RECEIVED

HIGH MEADOW (68-6263) RESERVOIR

AUG 26 2002

WATER RESOURCES DEPT.
SALEM, OREGON

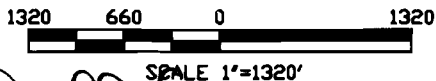

I, Thomas Terry, ADM Operations/Field Services agree to the findings of the CWRE and do submit this site report and map as my Claim of Beneficial Use of the water as provided under the terms and conditions of my Permit R-12361



THIS MAP IS FOR THE PURPOSE OF LOCATING A WATER RIGHT AND IS NOT INTENDED TO PROVIDE LEGAL DIMENSIONS FOR LOCATION OF PROPERTY BOUNDARIES.

ACAD2000/LDD
DWG FILE: HIGHMEADBEN

UNITED STATES DEPARTMENT OF THE INTERIOR
BUREAU OF LAND MANAGEMENT
DIVISION OF OPERATIONS VALE DISTRICT

HIGH MEADOW
(68-6263) RESERVOIR

DRAWN BY:
SURVEYED:
APPROVED:

ADM OPERATIONS AND FIELD SERVICES

DRAWN: CG

SCALE: 1"=1320'

DATE: 10/31/01

SHEET 1 OF 1

DRAWING NO. OR-03-9172.45-1083