

CLAIM OF BENEFICIAL USE MAP

UNDER APPLICATION R-82527 ; PERMIT R-12363


GOV'T LOT 3 SEC 2 T 41S. R 41E. W.M.

U.S.G.S. QUAD - BRETZ MINE OREG. - 7 1/2'


RECEIVED

JAN 04 2002

WATER RESOURCES DEPT
SALEM, OREGON

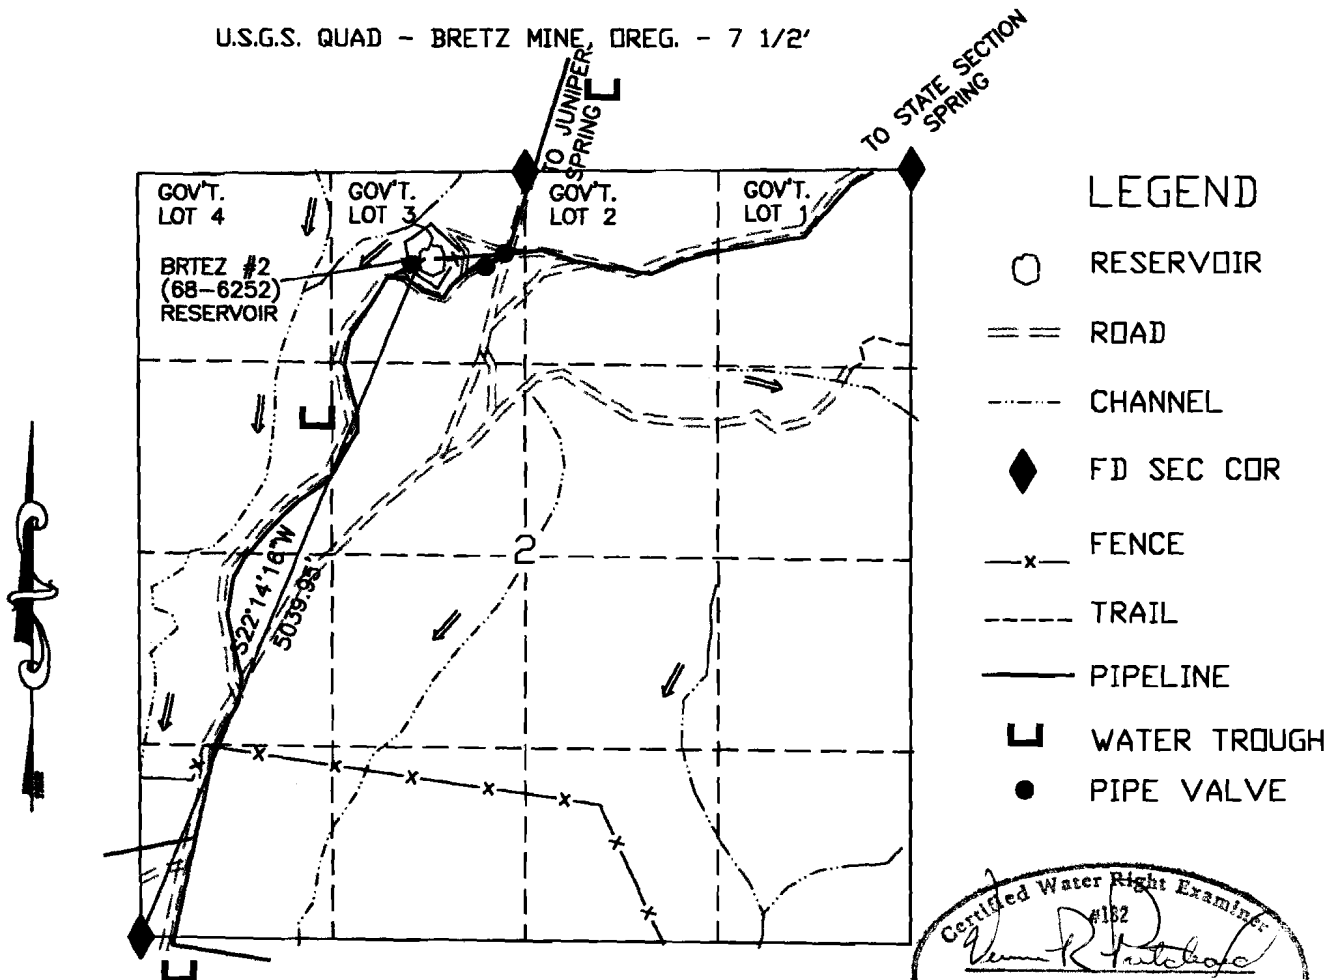

BRETZ #2 (68-6252) RESERVOIR

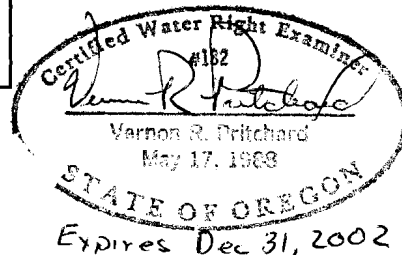

1320 660 0 1320
SCALE 1"=1320'

I, DAVID EVANS, Acting ADM Operations/Field Services agree to the findings of the CWRE and do submit this site report and map as my Claim of Beneficial Use of the water as provided under the terms and conditions of my Permit R-12363

ALWAYS
THINK
SAFETY

THIS MAP IS FOR THE PURPOSE OF LOCATING A WATER RIGHT AND IS NOT INTENDED TO PROVIDE LEGAL DIMENSIONS FOR LOCATION OF PROPERTY BOUNDARIES.

ACAD14
DWG FILE: BRETZ2ABEN

UNITED STATES DEPARTMENT OF THE INTERIOR
BUREAU OF LAND MANAGEMENT
DIVISION OF OPERATIONS VALE DISTRICT

BRETZ #2
(68-6252) RESERVOIR

DRAWN BY:

SURVEYED:

APPROVED

ADM OPERATIONS AND FIELD SERVICES

DRAWN: CG

SCALE: 1"=1320'

DATE: 11/02/00

SHEET 1 OF 1

DRAWING NO. OR-03-9172.45-1073