
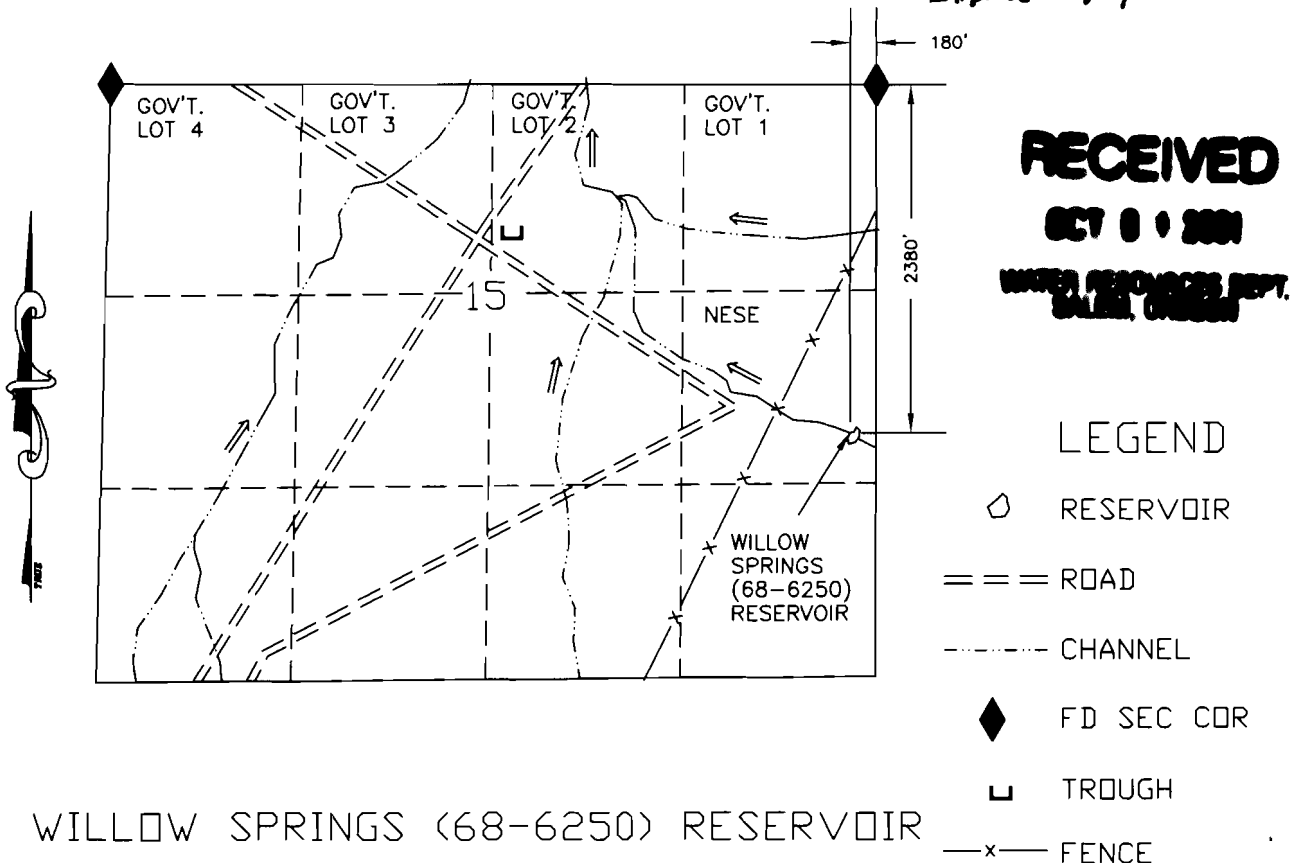


CLAIM OF BENEFICIAL USE MAP

UNDER APPLICATION R-82526; PERMIT R-12281

NE1/4 SE1/4 SEC 15 T 36S R 43E W.M.

U.S.G.S. QUAD - BATTLE CREEK RANCH, DREG. - 7 1/2'

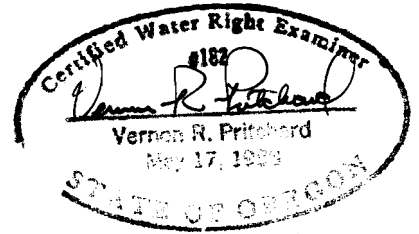

WILLOW SPRINGS (68-6250) RESERVOIR

1320 660 0 1320

SCALE 1"=1320'

I, Vernon R. Pritchard, Acting ADM Operations/Field Services agree to the findings of the CWRE and do submit this site report and map as my Claim of Beneficial Use of the water as provided under the terms and conditions of my Permit R-82526.

THIS MAP IS FOR THE PURPOSE OF LOCATING A WATER RIGHT AND IS NOT INTENDED TO PROVIDE LEGAL DIMENSIONS FOR LOCATION OF PROPERTY BOUNDARIES.



ACAD14
DWG FILEWILLOWSBEN

UNITED STATES DEPARTMENT OF THE INTERIOR
BUREAU OF LAND MANAGEMENT
DIVISION OF OPERATIONS VALE DISTRICT

WILLOW SPRINGS
(68-6250) RESERVOIR

DRAWN BY:

SURVEYED:

APPROVED

DRAWN:

DATE:

DRAWING NO.

CG

11/08/00

OR-03-9172.45-1095

SCALE:

SHEET

1 OF 1

1"=1320'

1095