


CLAIM OF BENEFICIAL USE MAP

UNDER APPLICATION R-82525; PERMIT R-12280

NE1/4 SW1/4 SEC 16 T 37S R 41E W.M.

U.S.G.S. QUAD - BLUE MOUNTAIN BASIN, OREG. - 7 1/2'

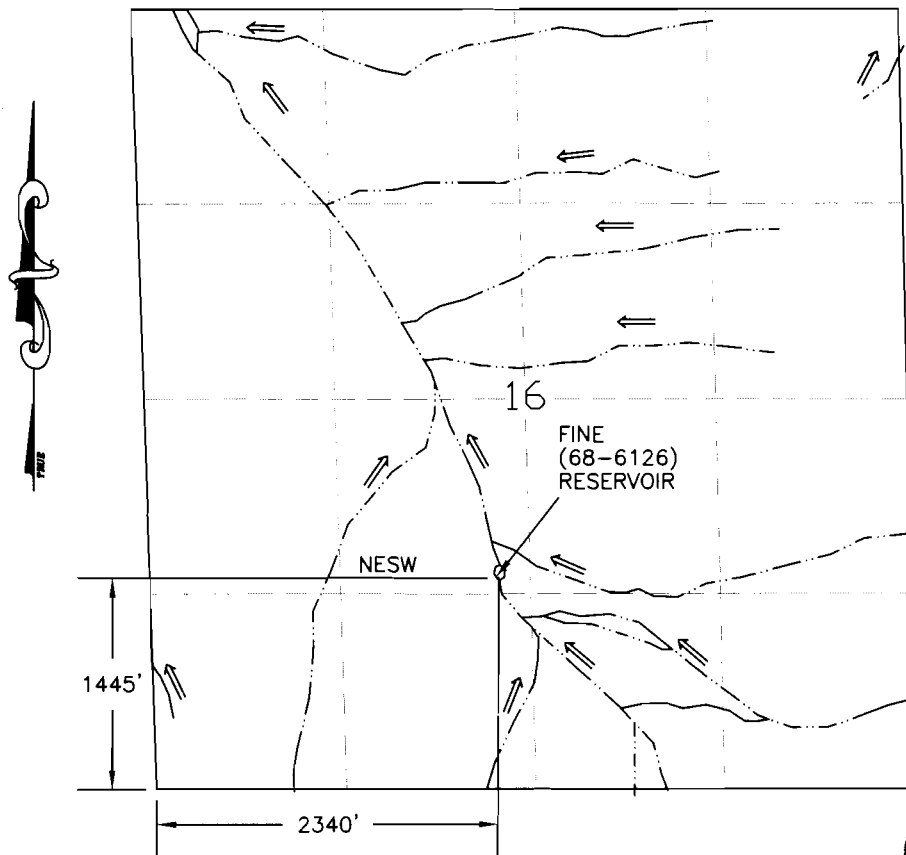

LEGEND

- RESERVOIR SHOWN ON QUAD
- CHANNEL

RECEIVED

OCT 9 3 2001

"BUTTERFLY"



Expires 12/31/02


1320 660 0 1320

SCALE 1"=1320'

I, Jerry Easton, Acting ADM Operations/Field Services agree to the findings of the CWRE and do submit this site report and map as my Claim of Beneficial Use of the water as provided under the terms and conditions of my Permit R-12280.



THIS MAP IS FOR THE PURPOSE OF LOCATING A WATER RIGHT AND IS NOT INTENDED TO PROVIDE LEGAL DIMENSIONS FOR LOCATION OF PROPERTY BOUNDARIES.

ACAD14
DWG FILE: FINEBEN

UNITED STATES DEPARTMENT OF THE INTERIOR
BUREAU OF LAND MANAGEMENT
DIVISION OF OPERATIONS VALE DISTRICT

FINE (68-6126)
RESERVOIR

DRAWN BY: Vernon R. Pritchard
SURVEYED: Jerry Easton
APPROVED: Jerry Easton
ADM OPERATIONS AND FIELD SERVICES

DRAWN: OG SCALE: 1"=1320'
DATE: 11/02/00 SHEET 1 OF 1
DRAWING NO. OR-03-9172.45-1079