


# CLAIM OF BENEFICIAL USE MAP

UNDER APPLICATION R-82514; PERMIT R-12271

SW1/4 SW1/4 SEC 22 T 21S R 41E W.M.


U.S.G.S. QUAD - AVERY CREEK, OREG. - 7 1/2'

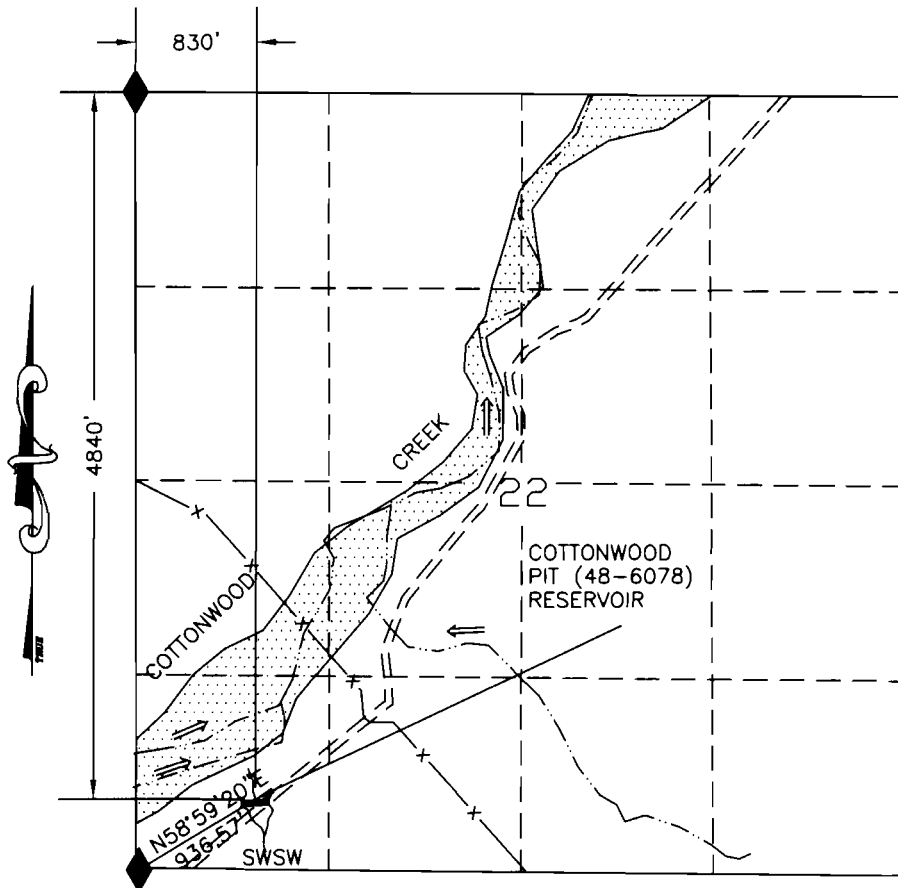

**RECEIVED**  
**SEC 0 1 200**  
**WATER RIGHT**

## LEGEND

- RESERVOIR
- ROAD
- CHANNEL
- FD SEC COR
- FENCE
- DRY RIVER BED

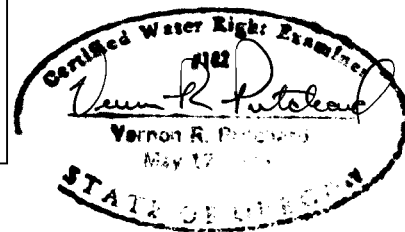

Expires 12/31/02

COTTONWOOD PIT (48-6078) RESERVOIR

1320 660 0 1320  
 SCALE 1"=1320'

I, Vernon R. Patek, Acting ADM Operations/Field Services agree to the findings of the CWRE and do submit this site report and map as my Claim of Beneficial Use of the water as provided under the terms and conditions of my Permit R-12271



THIS MAP IS FOR THE PURPOSE OF LOCATING A WATER RIGHT AND IS NOT INTENDED TO PROVIDE LEGAL DIMENSIONS FOR LOCATION OF PROPERTY BOUNDARIES.

ACAD14  
 DWG FILE: COTTONWPBEN

|   |                 |
|---|-----------------|
| UNITED STATES DEPARTMENT OF THE INTERIOR<br>BUREAU OF LAND MANAGEMENT<br>DIVISION OF OPERATIONS VALE DISTRICT |                 |
| COTTONWOOD PIT<br>(48-6078) RESERVOIR                                                                         |                 |
| DRAWN BY: <u>Vernon R. Patek</u>                                                                              |                 |
| SURVEYED: <u>Vernon R. Patek</u>                                                                              |                 |
| APPROVED: <u>Vernon R. Patek</u><br>ADM OPERATIONS AND FIELD SERVICES                                         |                 |
| DRAWN: <u>CG</u>                                                                                              | SCALE: 1"=1320' |
| DATE: <u>11/02/00</u>                                                                                         | SHEET 1 OF 1    |
| DRAWING NO. <u>OR-03-9172.45-1077</u>                                                                         |                 |