

RECEIVED

OCT 01 2001



WATER RESOURCES

CLAIM OF BENEFICIAL USE MAP

UNDER APPLICATION R-82513; PERMIT R-12270

SE1/4 NE1/4 SEC 27 T 19S R 40E W.M.

U.S.G.S. QUAD - LITTLE BLACK CANYON, OREG. - 7 1/2'

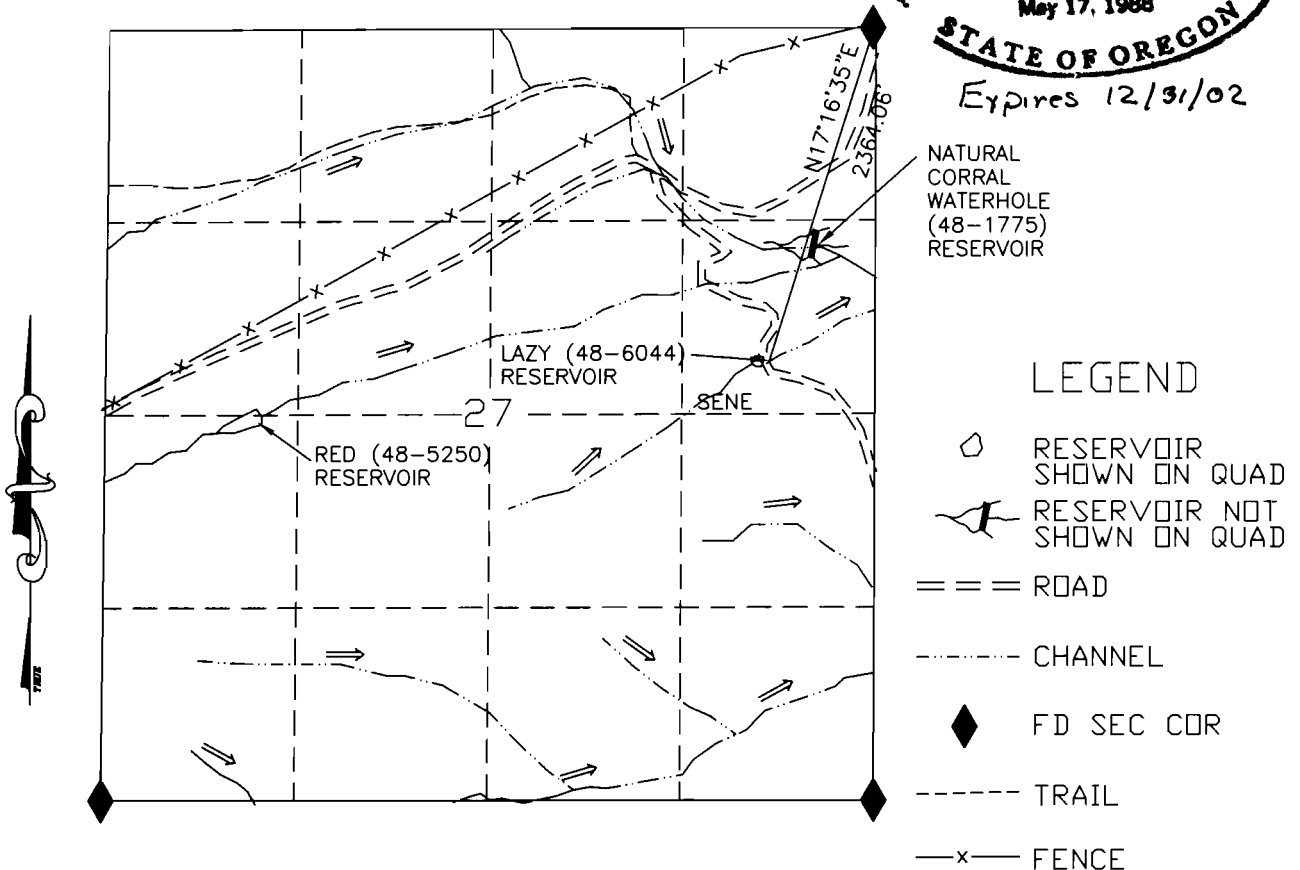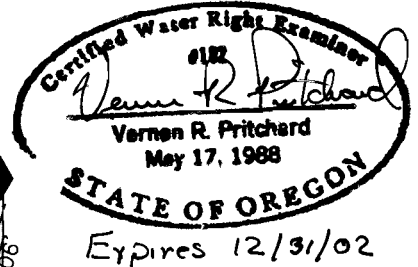

LAZY (48-6044) RESERVOIR

1320 660 0 1320
SCALE 1"=1320'

I, *Jerry Eastman*, Acting ADM Operations/Field Services agree to the findings of the CWRE and do submit this site report and map as my Claim of Beneficial Use of the water as provided under the terms and conditions of my Permit R-82513

Jerry Eastman



THIS MAP IS FOR THE PURPOSE OF LOCATING A WATER RIGHT AND IS NOT INTENDED TO PROVIDE LEGAL DIMENSIONS FOR LOCATION OF PROPERTY BOUNDARIES.

ACAD14
DWG FILE: LAZYBEN

UNITED STATES DEPARTMENT OF THE INTERIOR BUREAU OF LAND MANAGEMENT DIVISION OF OPERATIONS VALE DISTRICT	
LAZY (48-6044) RESERVOIR	
DRAWN BY: <i>Vernen R. Pritchard</i>	
SURVEYED: <i>Vernen R. Pritchard</i>	
APPROVED: <i>Jerry Eastman</i> ADM OPERATIONS AND FIELD SERVICES	
DRAWN: <i>CG</i>	SCALE: 1"=1320'
DATE: 11/02/00	SHEET 1 OF 1
DRAWING NO. OR-03-9172.45-1085	