
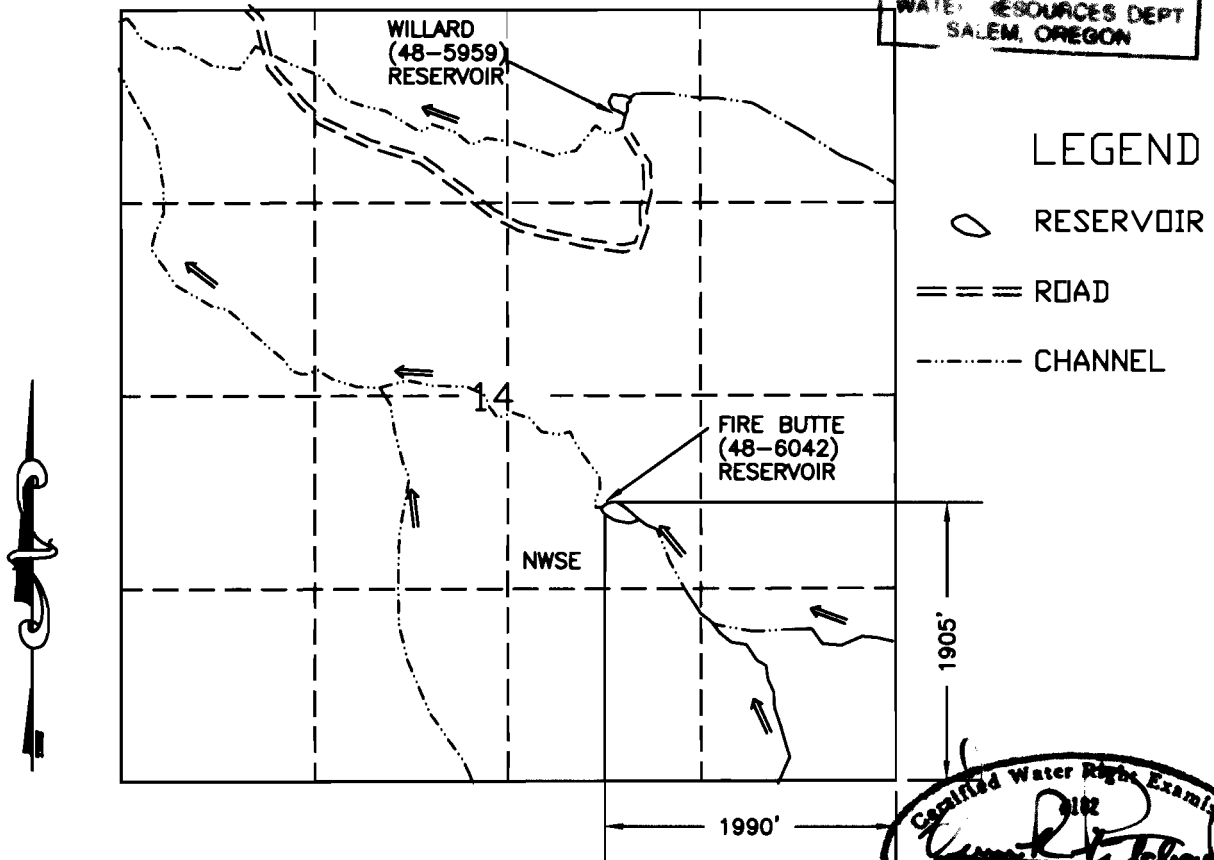


# CLAIM OF BENEFICIAL USE MAP



UNDER APPLICATION R-82512; PERMIT R-12269

NW1/4 SE1/4 SEC 14 T 25S R 37E W.M.

U.S.G.S. QUAD - MCEWEN BUTTE, OREG. - 7 1/2'

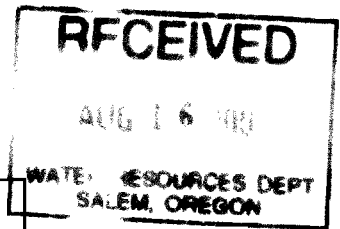

FIRE BUTTE (48-6042) RESERVOIR

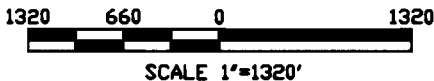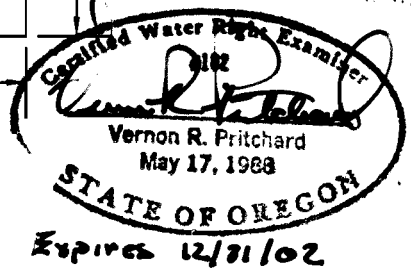

I, Thomas Terry, ADM Operations/Field Services agree to the findings of the CWRE and do submit this site report and map as my Claim of Beneficial Use of the water as provided under the terms and conditions of my Permit R-12269

*Thomas Terry*



THIS MAP IS FOR THE PURPOSE OF LOCATING A WATER RIGHT AND IS NOT INTENDED TO PROVIDE LEGAL DIMENSIONS FOR LOCATION OF PROPERTY BOUNDARIES.

ACAD2000/LDD  
DWG FILE: FIREBUTBEN

|   |                 |
|---|-----------------|
| UNITED STATES DEPARTMENT OF THE INTERIOR<br>BUREAU OF LAND MANAGEMENT<br>DIVISION OF OPERATIONS VALE DISTRICT |                 |
| FIRE BUTTE<br>(48-6042) RESERVOIR                                                                             |                 |
| DRAWN BY: <i>Vernon R. Pritchard</i>                                                                          |                 |
| SURVEYED: <i>Vernon R. Pritchard</i>                                                                          |                 |
| APPROVED: <i>Vernon R. Pritchard</i>                                                                          |                 |
| ADM OPERATIONS AND FIELD SERVICES                                                                             |                 |
| DRAWN: CG   | SCALE: 1"=1320' |
| DATE: 11/01/01                                                                                                | SHEET 1 OF 1    |
| DRAWING NO. OR-03-9172.45-1080                                                                                |                 |