


CLAIM OF BENEFICIAL USE MAP

UNDER APPLICATION R-82508 ; PERMIT R-12265

NE1/4 SE1/4 SEC 1 T 28S R 44E W.M.

U.S.G.S. QUAD - MCCAIN CREEK, OREG. - 7 1/2'

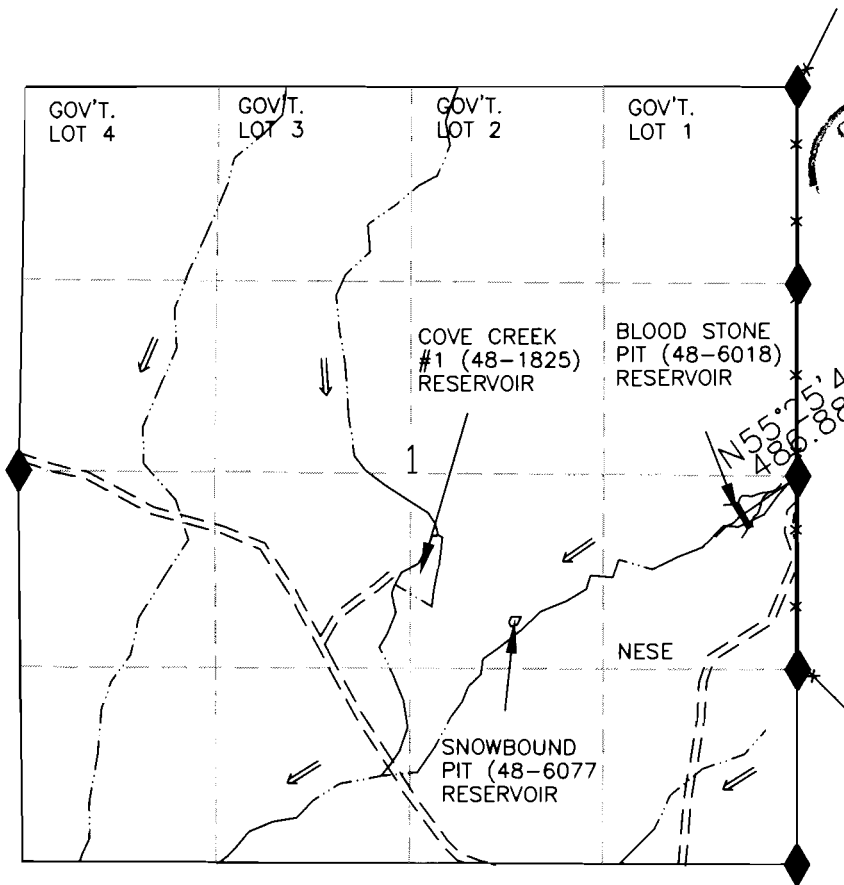


Certified Water Right Examined
 #183
Vernon R. Pritchard
 Vernon R. Pritchard
 May 17, 1988
 STATE OF OREGON
 Expires 12/31/02

LEGEND

- RESERVOIR ON U.S.G.S. QUAD
- RESERVOIR NOT ON QUAD
- ROAD
- CHANNEL
- FD SEC CDR
- FENCE

BLOOD STONE PIT (48-6018) RESERVOIR

RECEIVED
 OCT 8 2001
 WATER RESOURCES DEPT.
 SALEM, OREGON

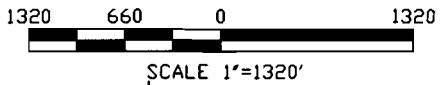

I, *[Signature]* Acting ADM Operations/Field Services agree to the findings of the CWRE and do submit this site report and map as my Claim of Beneficial Use of the water as provided under the terms and conditions of my Permit R-12265

[Signature]



THIS MAP IS FOR THE PURPOSE OF LOCATING A WATER RIGHT AND IS NOT INTENDED TO PROVIDE LEGAL DIMENSIONS FOR LOCATION OF PROPERTY BOUNDARIES.

ACAD14
 DWG FILE: BLOODSBEN.DWG

UNITED STATES DEPARTMENT OF THE INTERIOR BUREAU OF LAND MANAGEMENT DIVISION OF OPERATIONS VALE DISTRICT	
BLOOD STONE PIT (48-6018) RESERVOIR	
DRAWN BY: <i>[Signature]</i>	
SURVEYED: <i>[Signature]</i>	
APPROVED: <i>[Signature]</i> ADM OPERATIONS AND FIELD SERVICES	
DRAWN: CG	SCALE: 1"=1320'
DATE: 11/02/00	SHEET 1 OF 1
DRAWING NO. DR-03-9172.45-1072	