


- LEGEND**
- Point of Diversion (POD)
  - Conveyance
  - Place of Use (POU)
  - Donation Land Claim (DLC)
  - Tax Lot
  - Watercourse
  - Waterbody

**Claim of Beneficial Use Map  
Left Coast Cellars, LLC**

**RECEIVED**  
**JAN 10 2023**  
**OWRD**

**Application S-86459, Permit S-55403**  
Polk County  
Township 6, 7 South, Range 4 West (W.M.)

**CERTIFIED WATER RIGHTS EXAMINER STAMP**

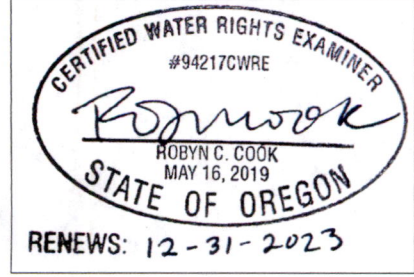

**LOCATION DESCRIPTION**  
**Reservoir E North**  
Located 1530 feet South and 55 West from the NE corner of Section 6, Township 7 South, Range 4 West (W.M.)  
Coordinates: Latitude: 44.994908, Longitude: -123.214909  
**Reservoir E South**  
Located 1920 feet South and 255 West from the NE corner of Section 6, Township 7 South, Range 4 West (W.M.)  
Coordinates: Latitude: 44.993823, Longitude: -123.215686

**RECEIVED**  
**MAR 20 2023**  
**OWRD**

**DISCLAIMER**  
This map was prepared for the purpose of identifying the location of a water right only and it is not intended to provide legal dimensions or location of property ownership lines.

Date: December 20, 2022  
Data Sources: BLM, ESRI, OWRD, USGS, Polk County