

**CLAIM OF
BENEFICIAL USE
for Reservoir Permits by
CWRE's (not self-certified)**



Oregon Water Resources Department
725 Summer Street NE, Suite A
Salem, Oregon 97301-1266
(503) 986-0900
www.oregon.gov/OWRD

**A fee of \$230 must accompany this form for permits
with priority dates of July 9, 1987, or later.
Claims received without the correct fee of \$200 will be returned.**

A separate form shall be completed for each permit.

In cases where a permit has been amended through the permit amendment process, a separate claim for the permit amendment is not required. Incorporate the permit amendment into the claim for the permit.

This form is subject to revision. **Begin each new claim** by checking for a new version of this form at:
<https://www.oregon.gov/OWRD/Forms/Pages/default.aspx>

The completion of this form is required by OAR 690-014-0100(1) and 690-014-0110(4).

Please type or print in dark ink. If this form is found to contain errors or omissions, it may be returned to you. **Every item must have a response.** If any requested information does not apply to the claim, insert "NA." **Do not delete or alter any section of this form unless directed by the form.** The Department may require the submittal of additional information from any water user or authorized agent.

"Section 8" of this form is intended to aid in the completion of this form and should not be submitted.

If you have questions regarding the completion of this form, please call 503-979-9103.

The Department has a program that allows it to enter into a voluntary agreement with an applicant for expedited services. Under such an agreement, the applicant pays the cost to hire additional staff that would not otherwise be available. This program means a certificate may be issued in about a month. For more information on this program see:

<https://www.oregon.gov/OWRD/programs/WaterRights/RA/Pages/default.aspx>

Received
SEP 20 2024
OWRD

**SECTION 1
GENERAL INFORMATION**

1. File Information

APPLICATION # R-74409	PERMIT # (IF APPLICABLE) R-11691	PERMIT AMENDMENT # (IF APPLICABLE)
---------------------------------	--	------------------------------------

2. Property Owner (current owner information)

APPLICANT/BUSINESS NAME THE DELPHIAN SCHOOL		503-843-3521		ADDITIONAL CONTACT NO.
ADDRESS 20950 SW ROCK CREEK RD.				
CITY SHERIDAN	STATE OR	ZIP 97378	E-MAIL DANAEA.JACKMAN@DELPHIAN.ORG	

If the current property owner is not the permit holder of record, it is recommended that an assignment be filed with the Department. *Each permit holder of record must sign this form.*

3. Permit holder of record (this may, or may not, be the current property owner)

PERMIT HOLDER OF RECORD THE DELPHIAN SCHOOL				
ADDRESS 20950 SW ROCK CREEK RD.				
CITY SHERIDAN	STATE OR	ZIP 97378		

ADDITIONAL PERMIT HOLDER OF RECORD				
ADDRESS				
CITY	STATE	ZIP		

Received

SEP 20 2024

OWRD

4. Date of Site Inspection:

07/21/2023

5. Person(s) interviewed and description of their association with the project:

NAME	DATE	ASSOCIATION WITH THE PROJECT
DANAEA JACKMAN	07/21/2023	FACILITIES DIRECTOR DELPHIAN SCHOOL

6. County

YAMHILL

7. If any property described in the place of use of the permit final order is excluded from this report, identify the owner of record for that property (ORS 537.230(5)):


OWNER OF RECORD				
ADDRESS				
CITY	STATE	ZIP		

Add additional tables for owners of record as needed

**SECTION 2
SIGNATURES**

CWRE Statement, Seal and Signature

The facts contained in this Claim of Beneficial Use are true and correct to the best of my knowledge.

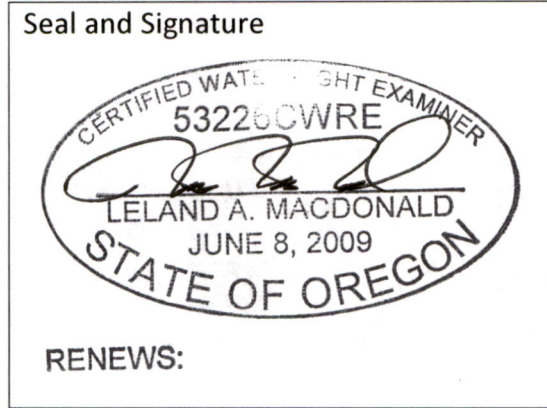

Received
SEP 20 2024
OWRD

CWRE NAME LELAND A. MACDONALD		PHONE NO. 503-472-7904	ADDITIONAL CONTACT NO. 503-434-3188
ADDRESS 3885 NE RIVERSIDE DR.			
CITY MCMINNVILLE	STATE OR	ZIP 97128	E-MAIL LEE@MACDONALDSURVEYING.COM

Permit Holder's of Record Signature or Acknowledgement

Each permit or transfer holder of record must sign this form in the space provided below.

The facts contained in this Claim of Beneficial Use are true and correct to the best of my knowledge. I request that the Department issue a water right certificate.

SIGNATURE	PRINT OR TYPE NAME	TITLE	DATE
	DANAEA JACKMAN	FACILITIES DIR.	

**SECTION 3
CLAIM DESCRIPTION**

1. Reservoir source and, if from surface water, the tributary:

RESERVOIR NAME OR NUMBER	SOURCE	TRIBUTARY
UNAMED	ASH CREEK	SOUTH YAMHILL RIVER

2. Developed use(s), period of use, and acre foot (af) for each use:

RESERVOIR NAME OR NUMBER	USES	SEASON OR MONTHS WHEN WATER WAS APPROPRIATED FOR STORAGE	VOLUME STORED (AF)
UNAMED	IRRIGATION OF 15 ACRES	3/1 – 10/31	9.59
Total Quantity of Water Stored			

3. Provide a general narrative description of the distribution works. This description must trace the water system from each point of diversion to the reservoir:

RESEVOIR IS FED BY AN INTERMITTENT SPRING AND RUNOFF

Reminder: The map associated with this claim must identify the location of the point(s) of diversion, Donation Land Claims (DLC), Government Lots (GLot), and Quarter-Quarters (QQ).

4. Variations:

Was the use developed differently from what was authorized by the permit, permit amendment final order, or extension final order? If yes, describe below. YES

(e.g. "The permit allowed the development of three reservoirs. The permit holder only developed one of the reservoirs." or "The permit allowed for the storage of 9 acre feet of water. The reservoir was developed to hold 5.2 acre feet.")

THE PERMIT ALLOWED FOR THE STORAGE OF 15 ACRE FEET OF WATER. THE RESEVOIR WAS DEVELOPED TO HOLD 9.59 ACRE FEET.

5. Claim Summary:

RESERVOIR NAME OR #	MAXIMUM STORAGE AUTHORIZED BY PERMIT (AF)	MAXIMUM STORAGE DEVELOPED (AF)
UNAMED	15	9.59

Received
SEP 20 2024
OWRD

SECTION 4
SYSTEM DESCRIPTION

Are there multiple reservoirs?

NO

If "YES" you will need to copy and complete Sections A through E for each reservoir.

Reservoir Name or Number this section describes (only needed if there is more than one):

A. Reservoir Location

1. Is the reservoir on-channel?

NO

2. Provide dam outlet location and/or point of diversion(s).

TWP	RNG	MER	SEC	QQ	GLOT	DLC	MEASURED DISTANCES
5S	6W	WM	29	SW NE	3		150' SOUTH, 350' EAST OF NW DLC #62

Reminder: The map associated with this claim must identify Donation Land Claims (DLC), Government Lots (GLOT), and Quarter-Quarters (QQ).

B. Diversion and Delivery System Information

Provide the following information concerning the diversion and delivery system. Information provided must describe the equipment used to transport the water from the point(s) of diversion to the reservoir.

1. Is a pump used?

NO

If "NO" items 2 through item 5 may be deleted.

6. Additional notes or comments related to the system:

THERE IS NO SYSTEM TO DELIVER WATER TO THE RESEVOIR, WATER IS FROM INTERMITTENT SPRING AND RUNOFF

C. Gravity Flow Pipe

(THE DEPARTMENT TYPICALLY USES THE HAZEN-WILLIAM'S FORMULA FOR A GRAVITY FLOW PIPE SYSTEM)

1. Does the system involve a gravity flow pipe?

NO

If "NO", items 2 through 4 relating to this section may be deleted.

D. Gravity Flow Canal or Ditch

(THE DEPARTMENT TYPICALLY USES MANNING'S FORMULA FOR CANALS AND DITCHES)

1. Is a gravity flow canal or ditch used to convey the water as part of the distribution system?

NO

If "NO", items 2 through 4 relating to this section may be deleted.

Received
SEP 20 2024

OWRD

E. Reservoir

1. Does the reservoir require the submittal of as-built plans and specifications? **YES**

If "YES", answer item 2; items 3 through 8 relating to this section may be deleted.

If "NO", skip items 2; answer items 3 through 8.

2. Complete the table:

HAVE THE DOCUMENTS BEEN SUBMITTED? YES OR NO	WHEN WERE THE DOCUMENTS SUBMITTED?	HAVE THEY BEEN APPROVED BY THE DEPARTMENT?	NUMBER OF ACRE FEET STORED
YES	7/19/2001	YES	9.59

SECTION 5 CONDITIONS

All conditions contained in the permit, permit amendment, or any extension final order shall be addressed. Reports that do not address all performance related conditions will be returned.

1. Time Limits:

Permits and any extension final orders contain any or all of the following dates; the date when the actual construction work was to begin, the date when the construction was to be completed, and the date when the complete application of water to the proposed was to be completed. These dates may be referred to as ABC dates. Describe how the water user has complied with each of the development timelines established in the permit or extension final order:

	DATE FROM PERMIT	DATE ACCOMPLISHED*	DESCRIPTION OF ACTIONS TAKEN BY WATER USER TO COMPLY WITH THE TIME LIMITS
ISSUANCE DATE	3/18/1996		
BEGIN CONSTRUCTION (A)	3/18/1997	PRIOR TO 3/18/1997	CLEARING & GRUBBING, EXCAVATION, EMBANKMENT
COMPLETE CONSTRUCTION (B)	10/1/1998 10/1/2011	8/15/2001	ADD BENTONITE SEALANT
COMPLETE APPLICATION OF WATER (C)	10/1/1999 10/1/2011	1/2/2002	BEGIN IRRIGATION

* must be within period between permit or any extension final order issuance and the date to completely apply water

2. Is there an extension final order(s)? **YES**

3. Measurement Conditions:

a. Does the permit, permit amendment, or any extension final order require the installation of a meter or approved measuring device? **YES**

If "NO", items b through f relating to this section may be deleted.

Reminder: If a meter or approved measuring device was required, the COBU map must indicate the location of the device in relation to the point of diversion or appropriation.

Received
SEP 20 2024
OWRD

b. Has a meter been installed? **YES**

c. Meter Information

POD/POA NAME OR #	MANUFACTURER	SERIAL #	CONDITION (WORKING OR NOT)	CURRENT METER READING	DATE INSTALLED
	SENSUS W-350	UNKNOWN	WORKING	23,364,500	2002

If a meter has been installed, items d through f relating to this section may be deleted.

4. Recording and reporting conditions

a. Is the water user required to report the water use to the Department? **YES**

If "NO", item b relating to this section may be deleted.

b. Have the reports been submitted? **NO**

If the reports have not been submitted, attach a copy of the reports if available.

5. Outlet Pipe

a. Is the water user required to install a minimum 8" outlet pipe/conduit? **YES**

If "NO", items b through c relating to this section may be deleted.

b. Has the outlet pipe been installed? **Received YES**

If "YES", items c relating to this section may be deleted.

SEP 20 2024

OWRD

6. Fish Screening

a. Are any points of diversion required to be screened to prevent fish from entering the point of diversion? **NO**

If "NO", items b through e relating to this section may be deleted.

7. By-pass Devices

a. Are any points of diversion required to have a by-pass device to prevent fish from entering the point of diversion? **NO**

If "NO", items b and c relating to this section may be deleted.

8. Other conditions required by permit, permit amendment final order, or extension final order

a. Was the water user required to restore the riparian area if it was disturbed? **NO**

b. Was a fishway required? **NO**

c. Was submittal of a letter from an engineer required prior to storage of water? **YES**

d. Was submittal of a water management and conservation plan required? **NO**

e. Other conditions? **NO**

If "YES" to any of the above, identify the condition and describe the water user's actions to comply with the condition(s):

SECTION 6
ATTACHMENTS

Provide a list of any additional documents you are attaching to this report:

ATTACHMENT NAME	DESCRIPTION
POND ASBUILT	AS BUILT CONDITIONS OF RESEVOIR, POND BOTTOM X-SECTION
COBU MAP	POND LOCATION, IRRIGATION AREAS, POD
PLACE OF USE	MAP OF IRRIGATIONS LINES & AREAS, AERIAL UNDERLAY

Received
SEP 20 2024
OWRD



ibution 4/27/2022

200 m Camera 1 275 m 45°06'

Received
SEP 20 2024



T. 5 S., R. 6 W., W.M.

FINAL PROOF SURVEY UNDER

IN NAME OF
DELPHIAN SCHOOL
Surveyed June 21, 2024

Application S-74408
Application R-74409

Permit 52013
Permit R-11691

Location:
The NE 1/4 of Section 29, U. S. LOT 3, T. 5 S., R. 6 W.,
W.M., Yamhill County, OR

Tax Lot: 5629 - 00100

Date: 26 JULY 2024

NW CORNER
FALCONER D.L.C. #62

Marcellus Falconer D.L.C. #62

150'

350'

U.S. LOT 3 SECTION 29

U.S. LOT 4 SECTION 29

By : Leland MacDonald & Assoc., LLC
Formerly dba Matt Dunckel & Assoc.
3885 Riverside Drive
McMinnville, Oregon 97128
Phone : 503-472-7904
Fax: 503-472-0367
Email: lee@macdonaldsurveying.com



RENEWS: 31 DECEMBER 2024

CONCRETE DRAIN
TOP ELEV. = 535.7'

POND 1

MAXIMUM WATER LEVEL
535.7' USED FOR POND
VOLUME

514

514

516

P.O.D.

520

528

536

540

6" PVC INTAKE LINE

PUMP BUILDING

IRRIGATION LINE TO CAMPUS

POND 1 HAS A VOLUME OF 9.59 ACRE FEET

TOP OF BANK

IRRIGATION LINE TO SOCCER FIELD


TO MAIN BUILDING

LEGEND:

- = Property line
- - - - = D.L.C. line
- = Section line
- = "40" line

P.O.D. = Point of Diversion

Note: This map is not intended to provide legal dimensions or locations of property ownership lines.

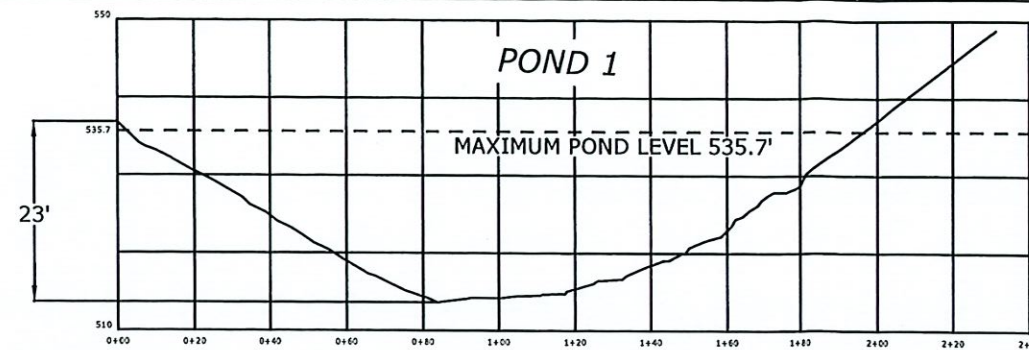

HORIZONTAL SCALE 1" = 50'
VERTICAL SCALE 1" = 25'



Received
SEP 20 2024

OWRD

Scale: 1" = 50'

