


CLAIM OF BENEFICIAL USE MAP

UNDER APPLICATION R-82503; PERMIT R-12260

SE1/4 SE1/4 SEC 11 T 24S R 43E W.M.

U.S.G.S. QUAD - QUARTZ MTN. BASIN, OREG. - 7 1/2'

RECEIVED
OCT 03 2000
"BUREAU OF LAND MANAGEMENT"

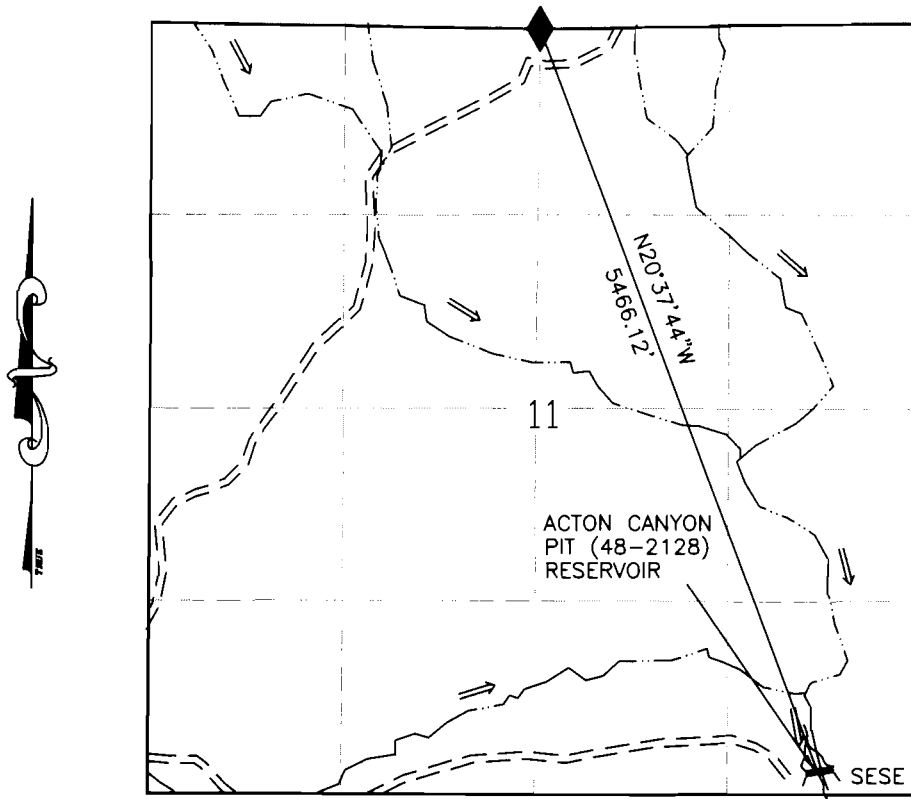

LEGEND

- RESERVOIR
- ROAD
- CHANNEL
- FD SEC COR

Certified Water Right
Vernon R. Pritchard
Vernon R. Pritchard
May 17, 1988
STATE OF OREGON
Expires 12/31/02

ACTON CANYON PIT (48-2128) RESERVOIR

1320 660 0 1320

SCALE 1"=1320'

I, *Jerry Eastman*, Acting ADM Operations/Field Services agree to the findings of the CWRE and do submit this site report and map as my Claim of Beneficial Use of the water as provided under the terms and conditions of my Permit R-12260.

THIS MAP IS FOR THE PURPOSE OF LOCATING A WATER RIGHT AND IS NOT INTENDED TO PROVIDE LEGAL DIMENSIONS FOR LOCATION OF PROPERTY BOUNDARIES.

**ALWAYS
THINK
SAFETY**

ACAD14
DWG FILE: ACTONCEN.DWG

UNITED STATES DEPARTMENT OF THE INTERIOR BUREAU OF LAND MANAGEMENT DIVISION OF OPERATIONS VALE DISTRICT	
ACTON CANYON PIT (48-2128)	
DRAWN BY: <i>Vernon R. Pritchard</i>	
SURVEYED: <i>Vernon R. Pritchard</i>	
APPROVED: <i>Jerry Eastman</i> ADM OPERATIONS AND FIELD SERVICES	
DRAWN: <i>CG</i>	SCALE: 1"=1320'
DATE: 11/02/00	SHEET 1 OF 1
DRAWING NO. OR-03-9172.45-1071	