


CLAIM OF BENEFICIAL USE MAP

TO ADD PLACE OF USE FOR STORAGE
PER APPLICATION R-67831
OREGON DEPARTMENT OF STATE LANDS



SE 1/4 SECTION 19 & SW 1/4 SECTION 20,
TOWNSHIP 28 SOUTH, RANGE 39 EAST, W.M.
TAX LOT: 101 MALHEUR COUNTY, OREGON

SCALE: 1 INCH = 500 FEET

PHOEBE

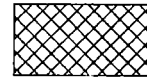

0.43 ACRE-FEET STO WITHIN SE 1/4
SE 1/4 SECTION 19 AND SW 1/4 SW
1/4 SECTION 20 FROM SEASONAL
RUNOFF, AS SHOWN.

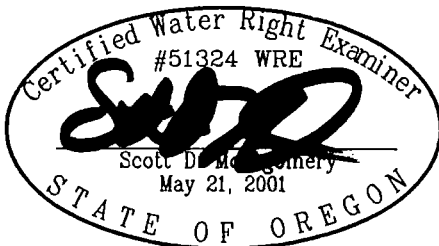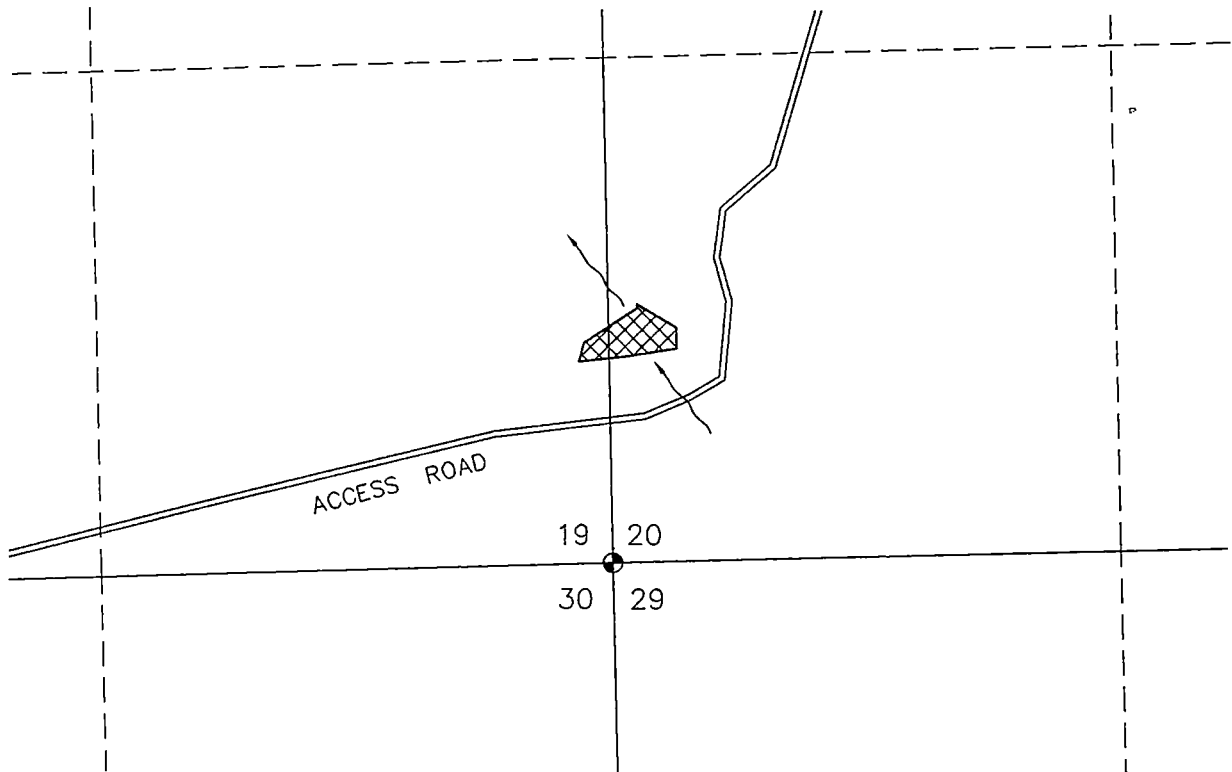




FOUND STONE PILE. ASSUMED AS BEST
EVIDENCE OF ORIGINAL CORNER.



INLET/OUTLET DITCH

THIS MAP IS FOR THE PURPOSE OF LOCATING A WATER RIGHT ONLY AND HAS NO
INTENT TO PROVIDE LEGAL DIMENSIONS OR THE LOCATION OF PROPERTY LINES.

PREPARED FOR:

OREGON DEPARTMENT OF STATE LANDS
775 SUMMER STREET NE #100
SALEM, OR 97301

PREPARED BY:



ALL POINTS ENGINEERING AND SURVEYING, INC.
P.O. BOX 767 TERREBONNE, OR 97760
(541) 548-5833
www.APEandS.com