


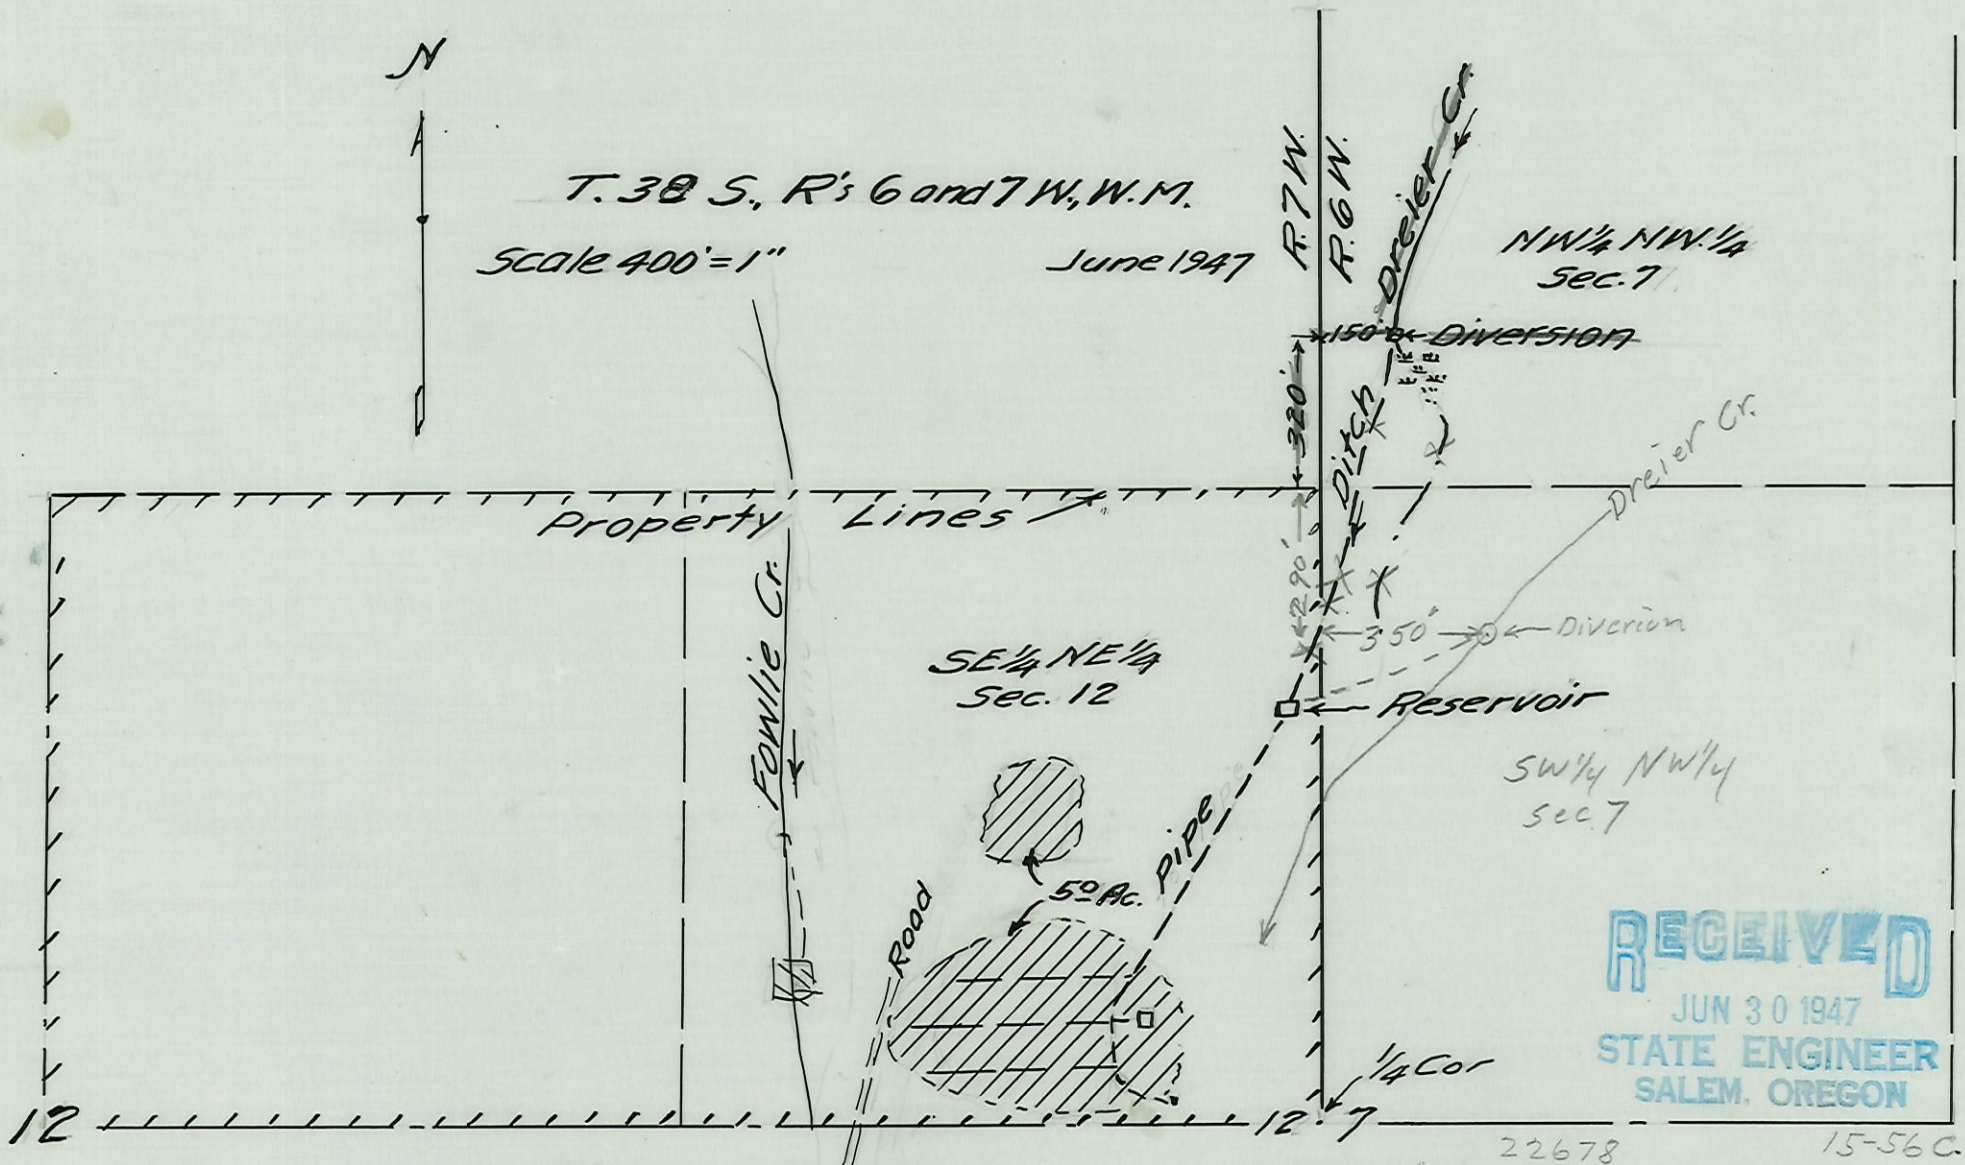

Caleb L. Dreier

Application No 22678
Permit No. 17837