


THIS MAP IS NOT INTENDED TO PROVIDE LEGAL DIMENSIONS OR LOCATIONS OF PROPERTY OWNERSHIP LINES.

IRRIGATED ACRES
 NE1/4NE1/4NW1/4= 5.32
 NW1/4NW1/4NE1/4= 3.83
 SW1/4NW1/4NE1/4= 8.03
 NE1/4SE1/4NW1/4= 4.54
 SE1/4NE1/4NW1/4= 5.37
 TOTAL 27.09

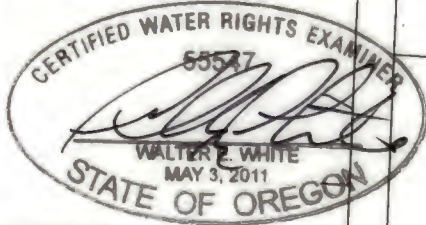

EXPIRES:

POND1: 4.1 AF
 POND2: 3.5 AF
 POND3: 7.8 AF
 TOTAL 15.4 AF

LEGEND

| SYMBOL | INDICATES |
|--------|------------------|
| --- | WATER LINES |
| --- | TAX LOT LINES |
| --- | CLAIM BOUNDARIES |
| PH1 | PUMP HOUSE |
| ● | WELL |

Received
 9 2024
 OWRD

W1/16

BATES ROAD

SECTION 29

28-14-29B
 TAX LOT 100

28-14-29B
 TAX LOT 600


NW1/16

28-14-29B
 TAX LOT 700

N1/4

NORTHWEST 1/4 OF SECTION 29, TOWNSHIP 28 SOUTH, RANGE 14 WEST, W.M., COOS COUNTY, OREGON

28-14-29A
 TAX LOT 800

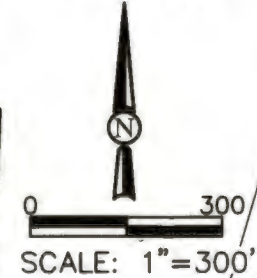

WELL1 AND METER
 3244' EAST AND
 905' SOUTH

28-14-29A
 TAX LOT 1000

STORAGE

WELL2 AND METER
 2917' EAST
 AND 1332'
 SOUTH

NW1/4
 SW1/4
 NE1/4

SECTION 29

WELL3 AND METER
 3210' EAST AND
 1705' SOUTH



Red Harvest Farms
 Claim of Beneficial Use
 Bandon, Oregon

Claim of Beneficial Use Map
 Appl: G-14686/Permit: g-13568
 SHN 623046

September 9, 2024

623046v

Figure 1

