



James E. Bussard
Consulting Engineer

SUBJECT:

FILE NO. McAllister
BY YEB DATE 11/96
SHEET NO. 1 OF 2

83386
112566

RECEIVED

APR - 2 1997

RESERVOIR APPLICATION MAP FOR WILLIAM R. MCALLISTER


WATER RESOURCES DEPT
SALEM, OREGON

RECEIVED

MAY - 5 1997

Sec. 11, T. 4 S, R. 12 E
W.M., Wasco County, Oregon

WATER RESOURCES DEPT
SALEM, OREGON

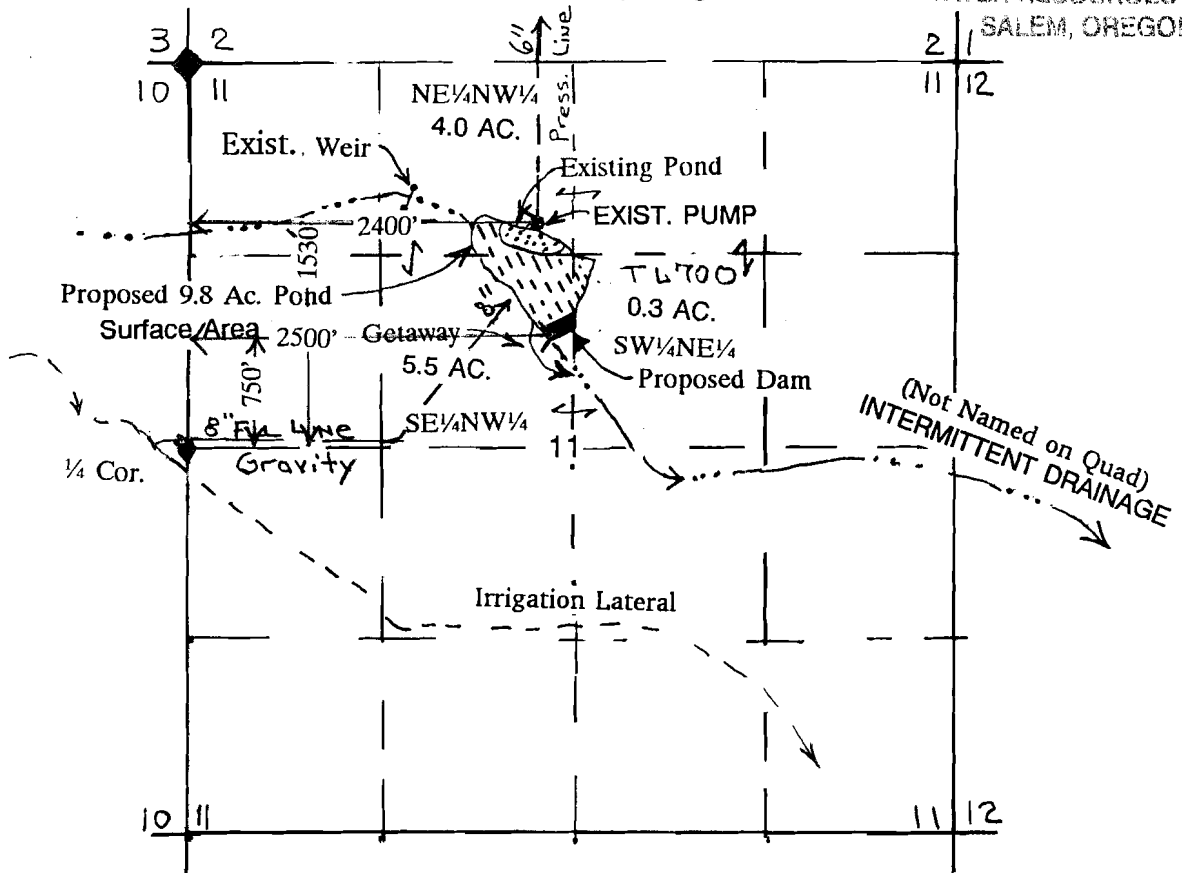

Scale: 4" = 1 Mile



Renewal Date: 12/31/97



This map is for the purpose of locating a proposed reservoir only and has no intent to provide the location of property lines or legal dimensions.