


# TOWNSHIP 1 SOUTH, RANGE 3 WEST, W.M.

PORTIONS OF SECTION 16  
WASHINGTON COUNTY, OREGON

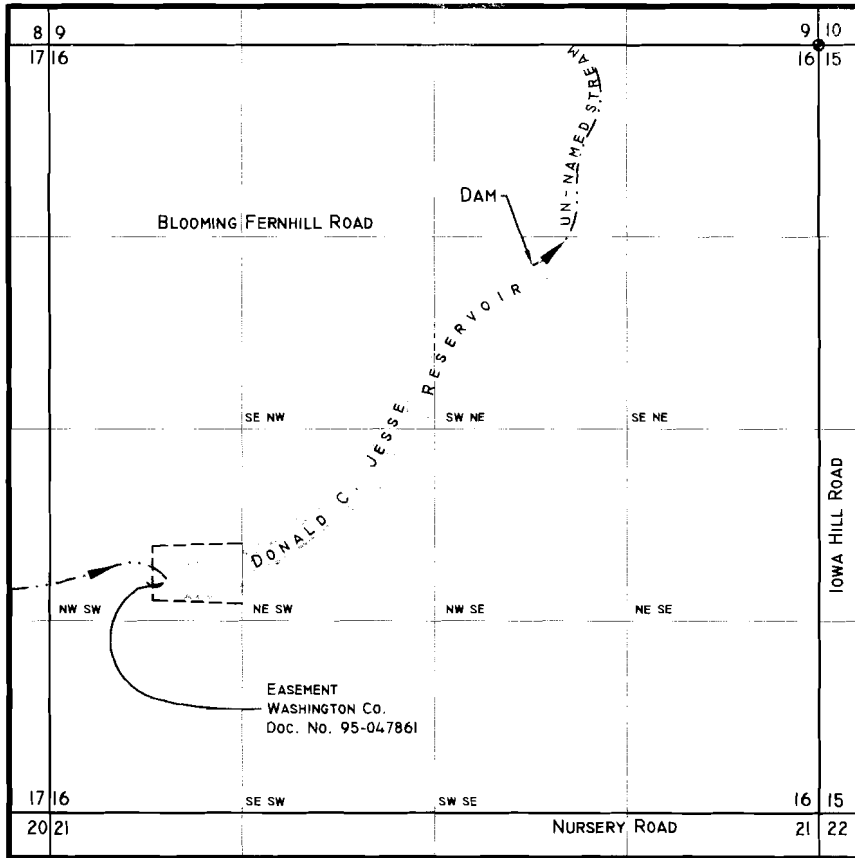


1" = 1320'

THE DAM LOCATED 1,546 FEET SOUTH AND 1,956 FEET WEST OF THE NORTHEAST CORNER OF SECTION 16, T.1S., R3W., W.M.

FINAL PROOF SURVEY  
UNDER  
APPLICATION NO. R-83362, PERMIT NO. R-12479  
IN THE NAME OF  
ALAN M. JESSE  
JAMES R. FURBY  
MAY 29, 2001

RECEIVED

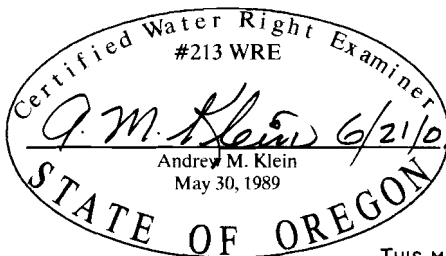

WATER RESOURCES DEPT  
SALEM, OREGON

Expires 6/30/2001

THIS MAP WAS PREPARED FOR THE PURPOSE OF IDENTIFYING THE LOCATION OF WATER RIGHT(S) ONLY AND IS NOT INTENDED TO PROVIDE LEGAL DIMENSIONS OR LOCATION OF PROPERTY OWNERSHIP LINES.