


FINAL PROOF

WATER RIGHT MAP

TL 700, SEC. 35, T17S, R6W, W.M.
LANE COUNTY, OREGON

00T 24 1997

WATER RESOURCES DEPT.
SALES OFFICE

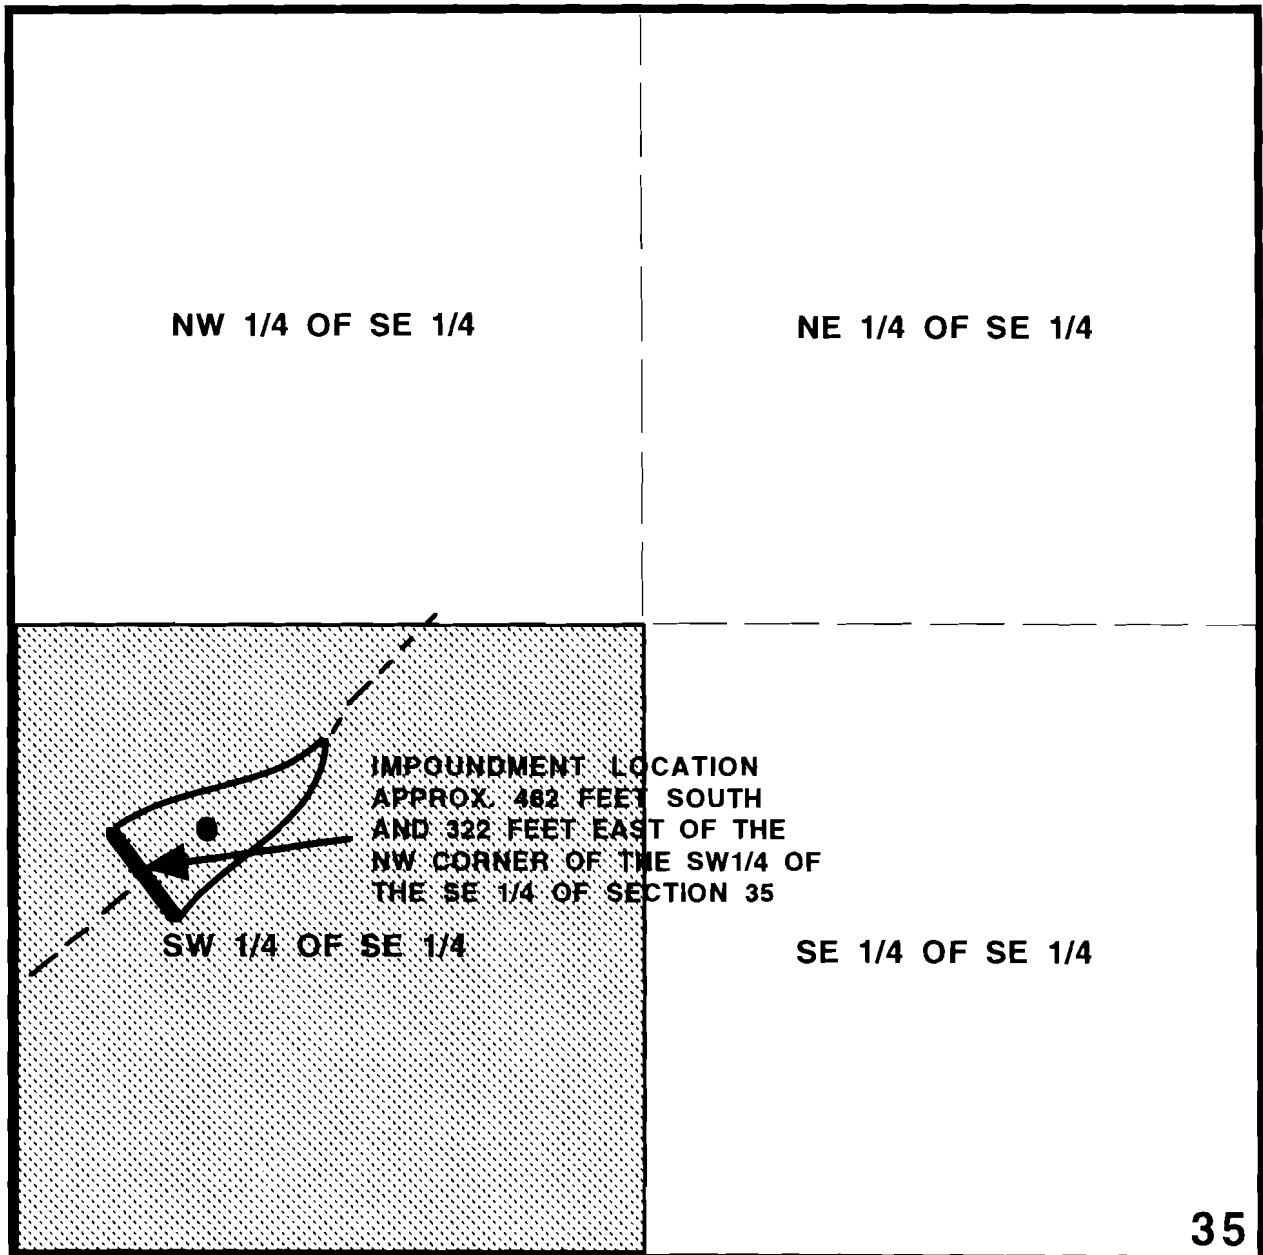


APPROXIMATE SCALE: 1" = 400'

● APPROXIMATE RESERVOIR LOCATION

FOR: Gregory Demers
P.O. Box 26139
Eugene, Oregon 97402

BY: EGR & Associates, Inc.
2535B Prairie Road
Eugene, Oregon 97402

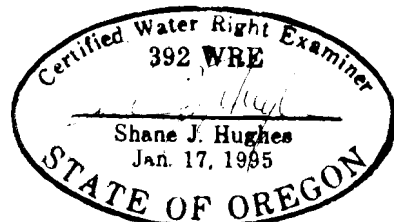

This map has been prepared for the sole purpose of identifying the requested water right location. There is no intent to provide dimensions or locations of property ownership lines