

Well • 1030 Feet South 300 Feet west of NE Section Corner


5 1W 14

SEC. 14 T.5S. R.1W. W. M.  
CLACKAMAS COUNTY


D.L.C. 8  
WM. ELLIOTT NO. 45  
J. MAGOON NO. 57

Received by OWRD  
SEP 26 2024  
Salem, OR

Cancelled  
300  
300  
600  
2704  
201  
302  
400  
2200T1  
205  
1490  
501  
304E1  
2601M1

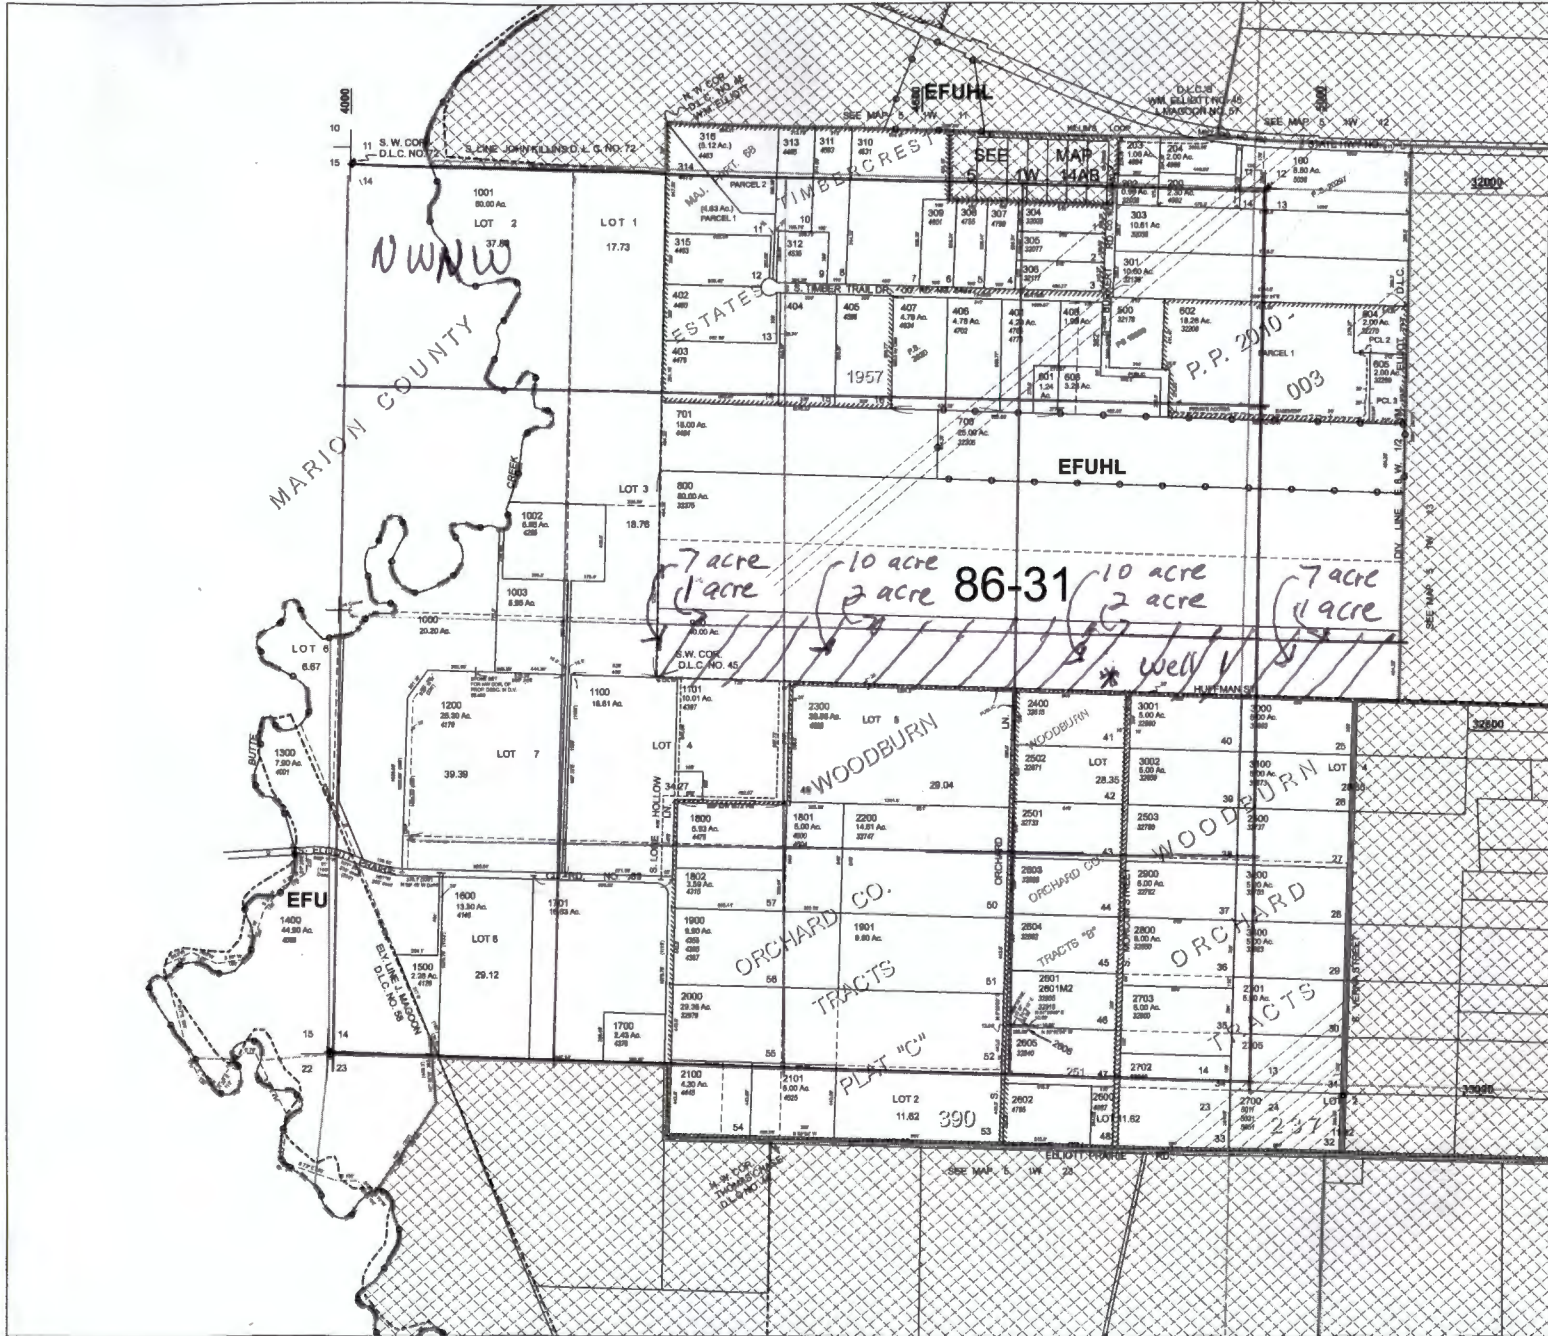

- Parcel Boundary
- - - Private Road ROW
- - - Historical Boundary
- - - Railroad Centerline
- Tax Code Lines
- Map Index
- Water Lines
- Land Use Zoning
- Plats
- Water
- ⊙ Corner
- Section Corner
- 1/16th Line
- Govt Lot Line
- - - DLC Line
- - - Meander Line
- - - PLS' Section Line
- ⊙ Historic Corridor 407
- ⊙ Historic Corridor 207

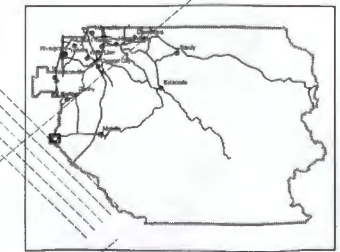

THIS MAP IS FOR ASSESSMENT PURPOSES ONLY

5 1W 14

Print Date: 1/22/2024