

**RECEIVED**

T.37 S. R.06 W. W.M. SECTION 4 MAR 16 2000


**FINAL PROOF SURVEY**

UNDER APPLICATION No. R-81556 PERMIT No. R-12151


WATER RESOURCES DEPT.  
SALEM, OREGON

IN NAME OF **ILA M. CROOK**

**SURVEYED MARCH 9, 2000 by JONATHAN C. SPERO**

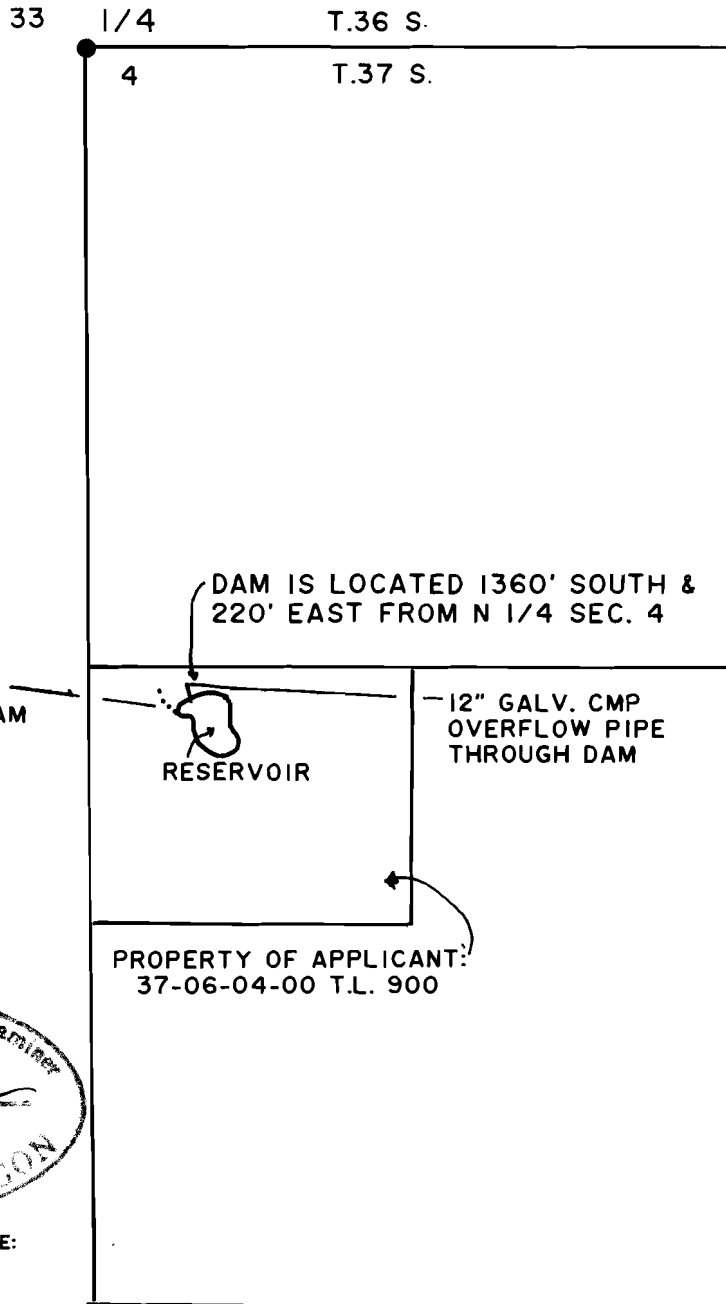

**SCALE: 1" = 400'**

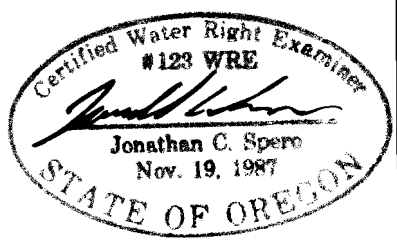

LICENSE RENEWAL DATE:  
JUNE 30, 2000

**PREPARED BY:  
JONATHAN C. SPERO C.W.R.E. 123  
1002 KINCAID RD./P.O. BOX 16  
WILLIAMS, OREGON 97544  
PH. (541) 846-6845**

THIS MAP IS FOR THE PURPOSE OF IDENTIFYING THE LOCATION OF THE WATER RIGHT ONLY, AND IS NOT INTENDED TO PROVIDE LEGAL DIMENSIONS OR LOCATIONS OF PROPERTY OWNERSHIP LINES.