



Oregon Water Resources Department  
 725 Summer Street NE, Suite A  
 Salem, Oregon 97301  
 (503) 986-0900  
 www.oregon.gov/OWRD

**E-RECEIVED**  
 9/30/2024  
**OWRD**

## Ownership Update for Certificated Rights Only

### NO FEES ARE REQUIRED TO SUBMIT THIS FORM

**NOTICE:** A certificate of water right typically stays with the land. To track water right ownership, the Department requests that this form be submitted to the Department. **To update multiple rights, a separate form is required for each right.** If you have any questions about this form, please contact your local watermaster, or call the Water Resources Department at (503) 986-0900.

Note: Use the assignment form to change ownership on pending applications, permits, transfers, groundwater registrations, or limited licenses.

Current Landowner Information					
Name:	TIMOTHY PFIEFFER & MARYALICE PFIEFFER				
Mailing Address:	10400 NW MOORES VALLEY RD				
City:	YAMHILL	State:	OR	Zip:	97148
Phone:	503-537-4821	Email:	tpfeiffer2@frontier.com		


Property Information							
County:	Yamhill	Township:	3S	Range:	4W	Section:	6
Tax Lot #:	1101, 1200, & 1201 (Tax map 3 4 06)						
Street Address of Water Right:	no situs						
Water Right Information							
Application:	S-17795						
Permit:	S-13474						
Certificate:	20424						
Are all the lands associated with this water right owned by the requestor?						<input type="checkbox"/> Yes	<input checked="" type="checkbox"/> No
(If no, include a map showing the portion of the water right involved)							

Signature and Date			
Name of individual completing form:	Timothy L Pfeiffer		
Phone or email:	tpfeiffer2@frontier.com	Date:	9-25-24
Signature of requestor:			

The Department does not change names on water right certificates. This form will be placed in the file for future reference only. If mailed, the Department will not provide acknowledgment of receipt.

This form can be mailed to the address above or sent by email to [wrd\\_dl\\_customerservice@water.oregon.gov](mailto:wrd_dl_customerservice@water.oregon.gov)

T.3S. R. 4W.W.M.

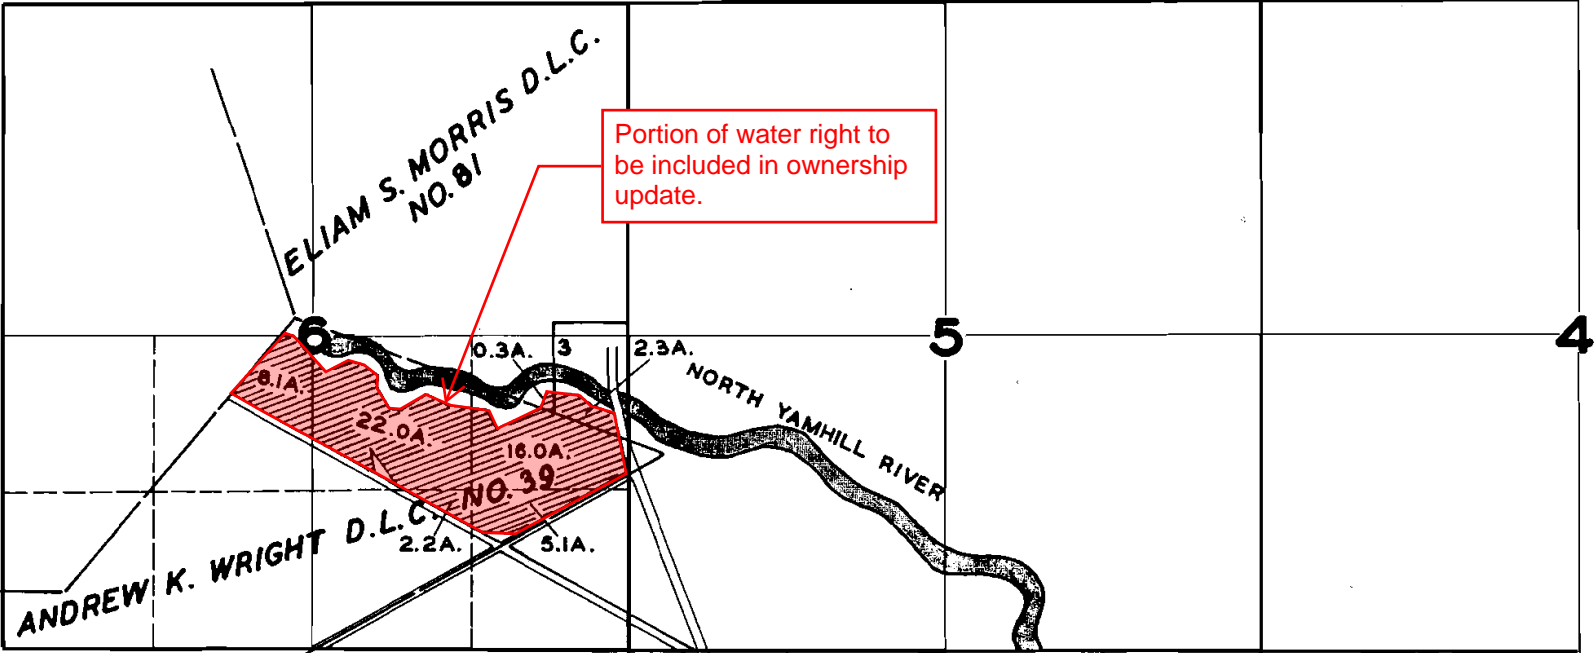

**FINAL PROOF SURVEY**  
 UNDER  
 Application No. 17795 Permit No. 13474  
 IN NAME OF  
THEODORE M. BERNARDS  
 Surveyed MAY 2, 1947, by JAS. E. BUNNELL

