

LEGEND

	SECTION LINE
	1/4 1/4 LINE
	TAX LOT LINE
	DITCH LINE
	ROAD
	FLOW DIRECTION
	SECTION CORNER
	TAX LOT NUMBER
	WELL
	SUPPLEMENTAL IRRIGATION LANDS UNDER PERMIT G-17506
	SUPPLEMENTAL IRRIGATION ACRES 1/4 1/4 SECTION

NOTES:

1. THIS MAP WAS PREPARED FROM FIELD MEASUREMENTS, NAIP 2024 AERIAL PHOTOGRAPHS, KLAMATH COUNTY TAX MAPS, AND OREGON GLO MAPS.
2. THE PURPOSE OF THIS MAP IS TO IDENTIFY THE LOCATION OF THE WATER RIGHT ONLY, AND IS NOT INTENDED TO PROVIDE DIMENSIONS OR LOCATION OF PROPERTY LINES.
3. DATE OF PRIORITY FOR THIS WATER RIGHT IS SEPTEMBER 5, 2002.

WELL LOCATIONS:


WELL 4 (KLAM 56638): 60' SOUTH & 670' WEST FROM THE NORTHEAST CORNER OF SECTION 20
 WELL 5 (KLAM 57662): 20' SOUTH & 200' EAST FROM THE NORTH QUARTER CORNER OF SECTION 19.

Received by OWRD
 OCT 02 2024
 Salem, OR

ADKINS ENGINEERING & SURVEYING
 o / 541.884.4666
 w / AdkinsEngineering.com
 1435 ESPLANADE AVENUE, KLAMATH FALLS, OR 97601

SERVING S. OREGON & N. CALIFORNIA

ENGINEERING • SURVEYING • PLANNING • TESTING

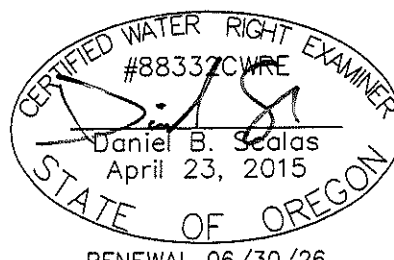

RENEWAL 06/30/26

CLAIM OF BENEFICIAL USE AND FINAL PROOF MAP
 FOR
 ROGER NICHOLSON / AGRI-WATER LLC
 T33S, R7.5E, SECS. 20 & 29, WM
 KLAMATH COUNTY, OREGON
 PERMIT G-17506
 APPLICATION G-15834