



E-RECEIVED  
OCT 7, 2024  
OWRD

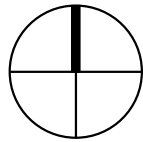

# T05S, R01W, SECTION 6

1" = 500'

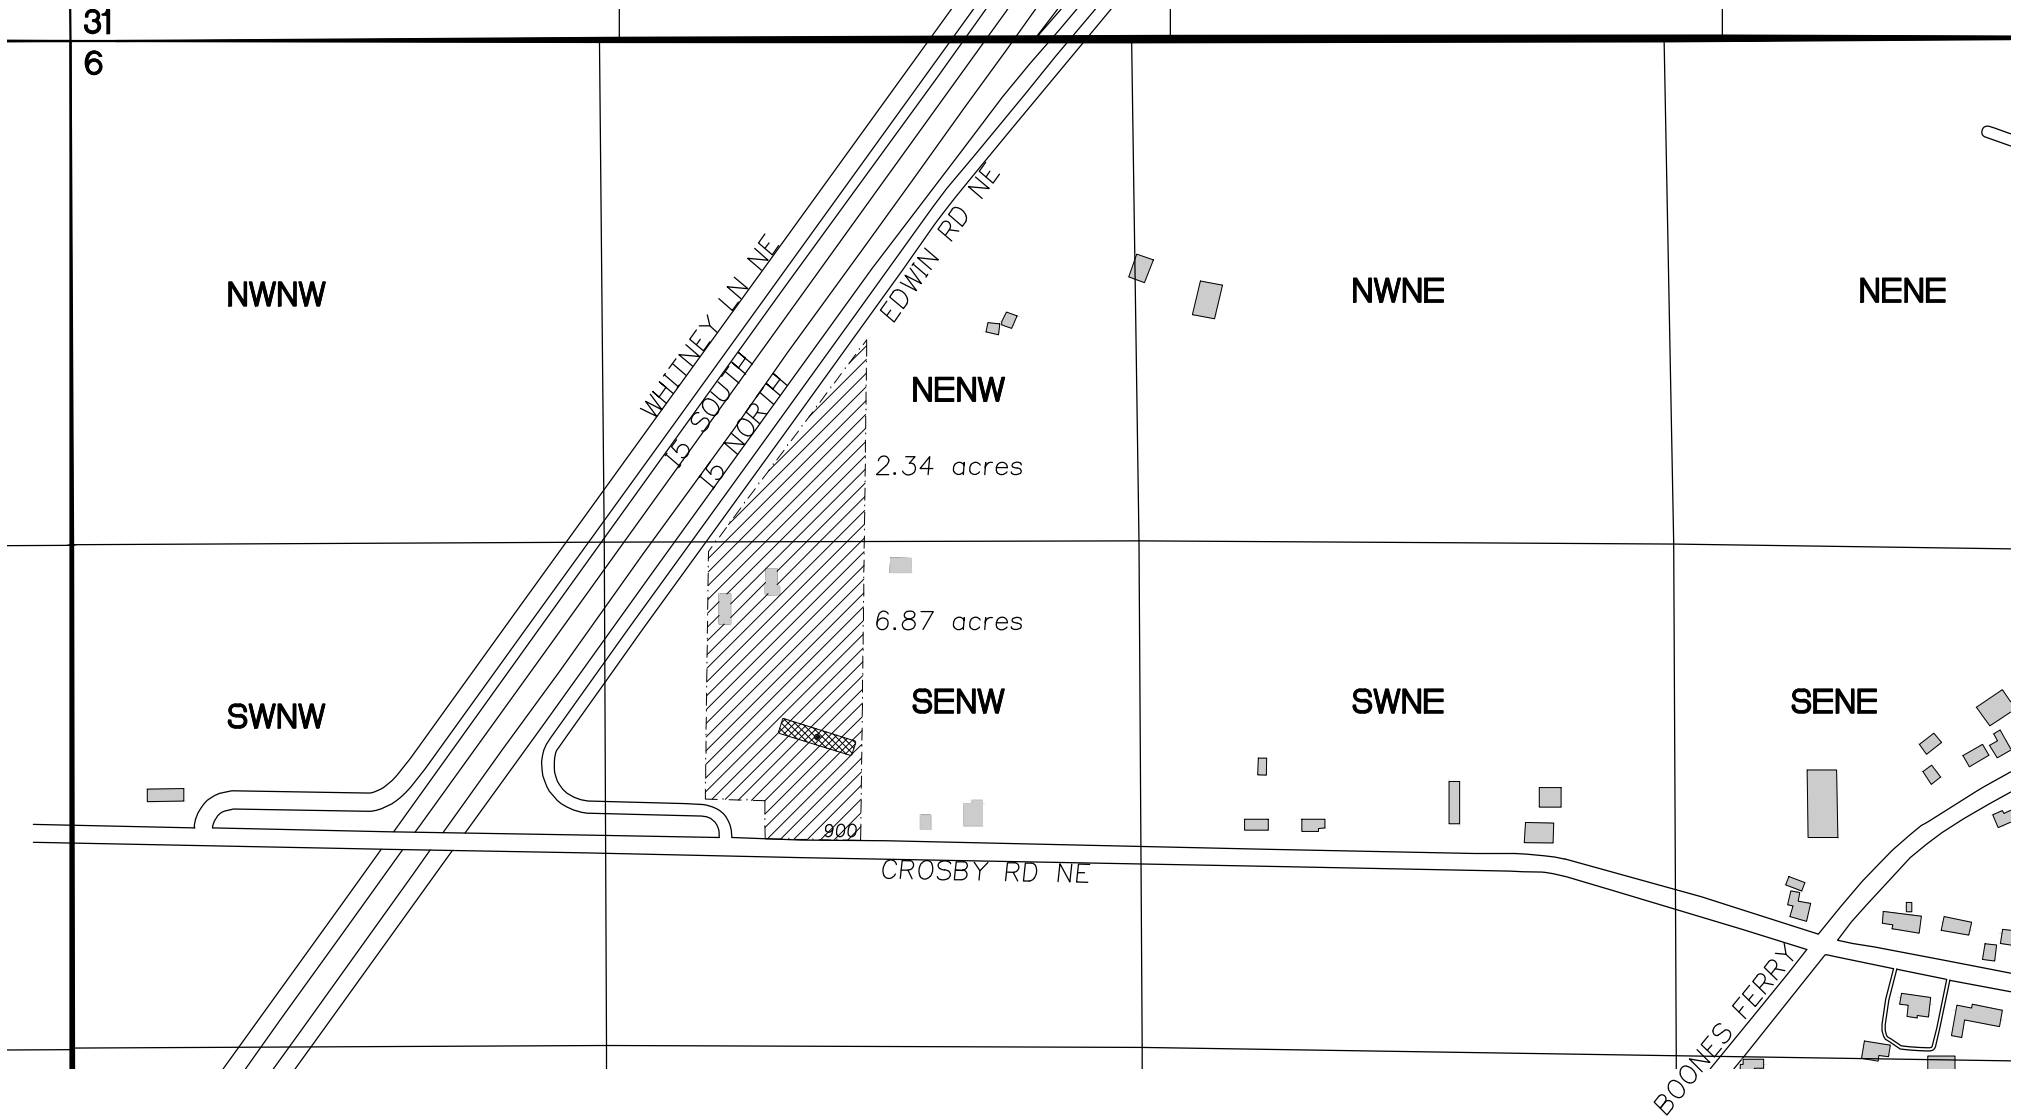

Proposed pond located 1,812 ft South and 1,941 ft East from NW corner of section 6

Proposed irrigation area    Proposed pond location    Existing Buildings    Property Line