



Oregon Water Resources Department
 725 Summer Street NE, Suite A
 Salem, Oregon 97301
 (503) 986-0900
 www.oregon.gov/OWRD

Ownership Update for Certificated Rights Only

NO FEES ARE REQUIRED TO SUBMIT THIS FORM

NOTICE: A certificate of water right typically stays with the land. To track water right ownership, the Department requests that this form be submitted to the Department. **To update multiple rights, a separate form is required for each right.** If you have any questions about this form, please contact your local watermaster, or call the Water Resources Department at (503) 986-0900.

Note: Use the assignment form to change ownership on pending applications, permits, transfers, groundwater registrations, or limited licenses:

Current Landowner Information					
Name:	MARVIN SLATER & EILEEN SLATER				
Mailing Address:	12184 NW MOORES VALLEY RD				
City:	YAMHILL	State:	OR	Zip:	97148
Phone:		Email:			

Property Information					
County:	Yamhill	Township:	3S	Range:	4W
		Section:	6		
Tax Lot #:	2400 (Tax map 3 4 06)				
Street Address of Water Right:	no situs				
Water Right Information				Received by OWRD	
Application:	S-45639	OCT 07 2024			
Permit:	S-34035	Salem, OR			
Certificate:	39108				
Are all the lands associated with this water right owned by the requestor?				<input type="checkbox"/> Yes	<input checked="" type="checkbox"/> No
(If no, include a map showing the portion of the water right involved)					


Signature and Date		
Name of individual completing form:	Marvin Slater	
Phone or email:	503-662-3816	Date: 10/7/24
Signature of requestor:	Marvin Slater	

The Department does not change names on water right certificates. This form will be placed in the file for future reference only. If mailed, the Department will not provide acknowledgment of receipt.

This form can be mailed to the address above or sent by email to wrd_dl_customerservice@water.oregon.gov

T. 3 S. R. 4 & 5 W. W. M.

Portion of water right to be included in ownership update.

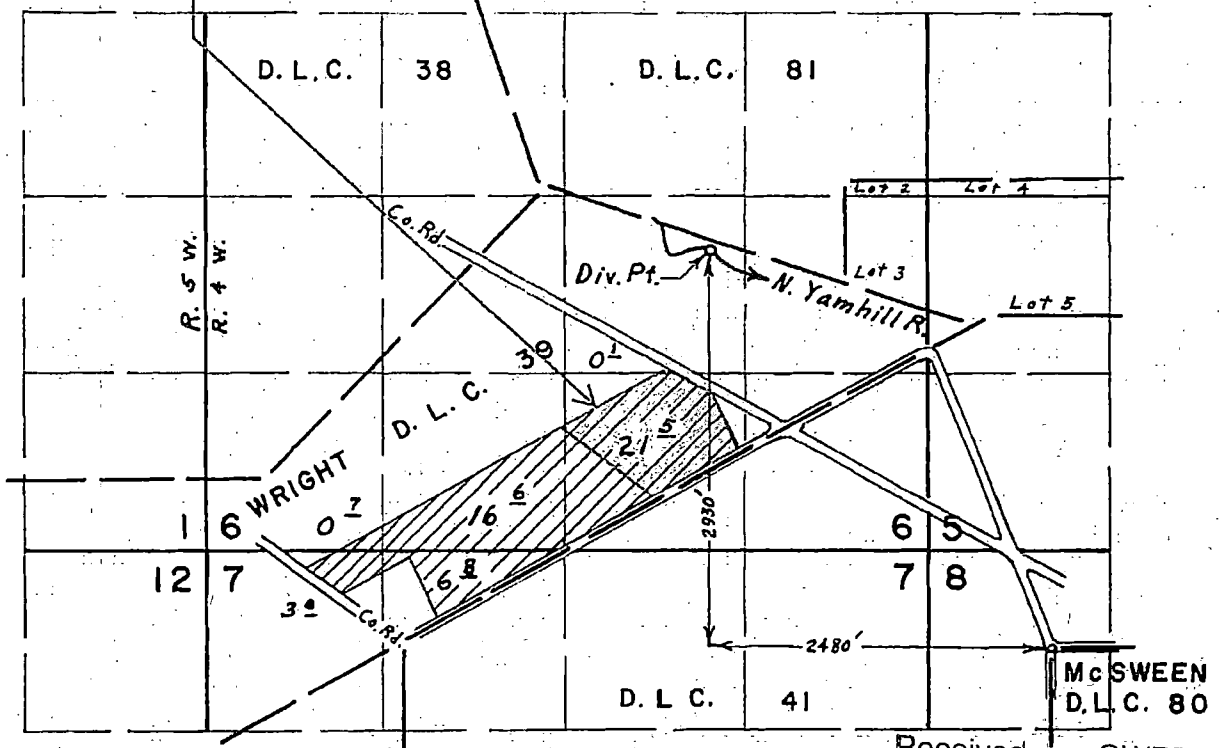

Received by OWRD

OCT 07 2024

Salem, OR

FINAL PROOF SURVEY UNDER

Application No. 45639 Permit No. 34035
IN NAME OF

FIDEL BROS.

Surveyed Oct. 27, 1971, by L. E. Gould