



Oregon Water Resources Department
 725 Summer Street NE, Suite A
 Salem, Oregon 97301
 (503) 986-0900
 www.oregon.gov/OWRD

E-RECEIVED

10/7/2024

OWRD

Ownership Update for Certificated Rights Only

NO FEES ARE REQUIRED TO SUBMIT THIS FORM

NOTICE: A certificate of water right typically stays with the land. To track water right ownership, the Department requests that this form be submitted to the Department. **To update multiple rights, a separate form is required for each right.** If you have any questions about this form, please contact your local watermaster, or call the Water Resources Department at (503) 986-0900.

Note: Use the assignment form to change ownership on pending applications, permits, transfers, groundwater registrations, or limited licenses.

| Current Landowner Information | | | |
|-------------------------------|-------------------------------|--------|---------------|
| Name: | MARVIN SLATER & EILEEN SLATER | | |
| Mailing Address: | 12184 NW MOORES VALLEY RD | | |
| City: | YAMHILL | State: | OR Zip: 97148 |
| Phone: | | Email: | |

| Property Information | | | |
|--|-----------------------|--------------------------|--|
| County: | Yamhill | Township: | 3S Range: 4W Section: 6 |
| Tax Lot #: | 2400 (Tax map 3 4 06) | | |
| Street Address of Water Right: | no situs | | |
| Water Right Information | | | |
| Application: | S-41927 | | |
| Permit: | S-31385 | | |
| Certificate: | 39106 | | |
| Are all the lands associated with this water right owned by the requestor? | | <input type="checkbox"/> | Yes <input checked="" type="checkbox"/> No |
| (If no, include a map showing the portion of the water right involved) | | | |


| Signature and Date | |
|-------------------------------------|----------------------------|
| Name of individual completing form: | Marvin Slater |
| Phone or email: | 503-662-3816 Date: 10/7/24 |
| Signature of requestor: | Marvin Slater |

The Department does not change names on water right certificates. This form will be placed in the file for future reference only. If mailed, the Department will not provide acknowledgment of receipt.

This form can be mailed to the address above or sent by email to wrd_dl_customerservice@water.oregon.gov

T. 3 S.R. 4 & 5 W.W.M.

Portion of water right to be included in ownership update.

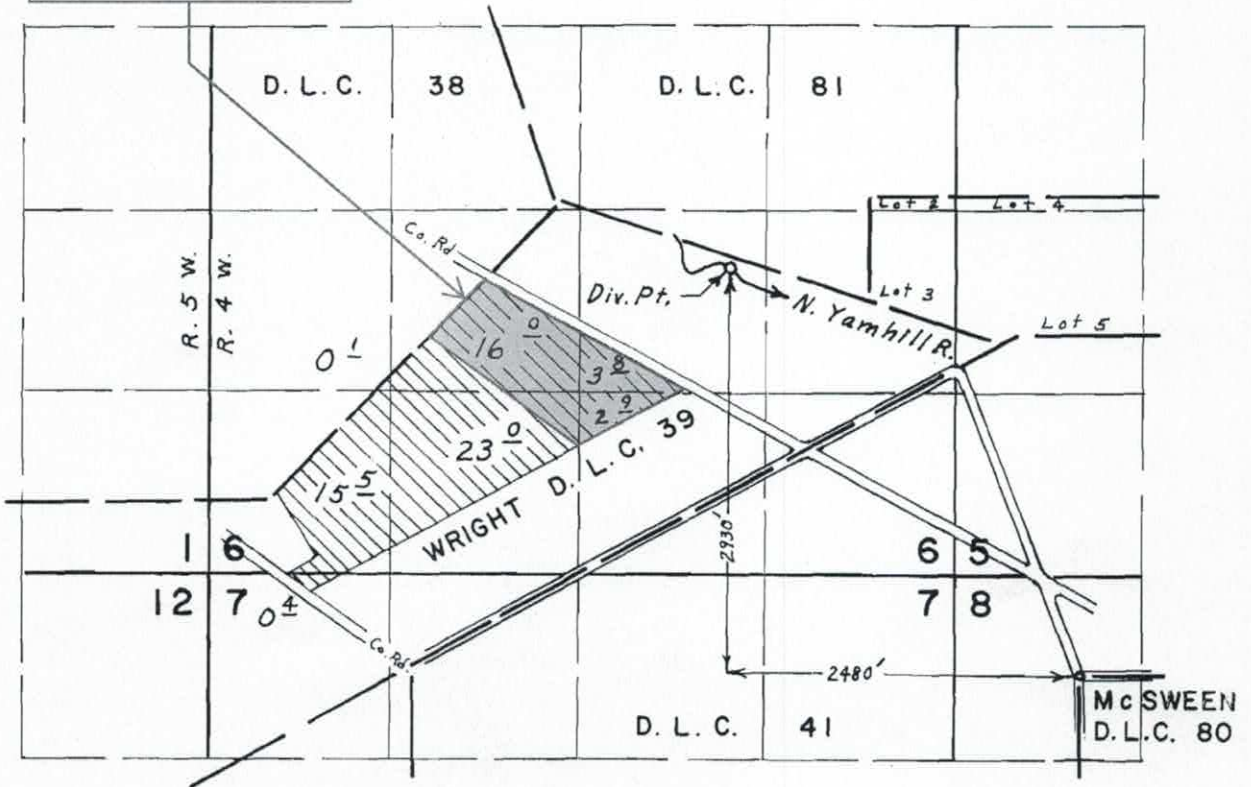

FINAL PROOF SURVEY UNDER

Application No. 41927 Permit No. 31385
 IN NAME OF
MARK FIDEL

Surveyed Oct. 27, 1971, by L. E. Gould