

RECEIVED

JUL 25 2008

WATER RESOURCES
SALEM OREGON

ml
7/25/08

CANCELLED TAX LOTS
1702
1703
2000


This map was prepared for
assessment purpose only.

NW1/4 SEC.29 T.3S. R.4E W.M.
CLACKAMAS COUNTY

$\frac{1}{11} = 400$
SEE MAP 3 4E 20

D. L. C.
FREDRICK HELMS NO.

SEE MAP 3 4E 20C0

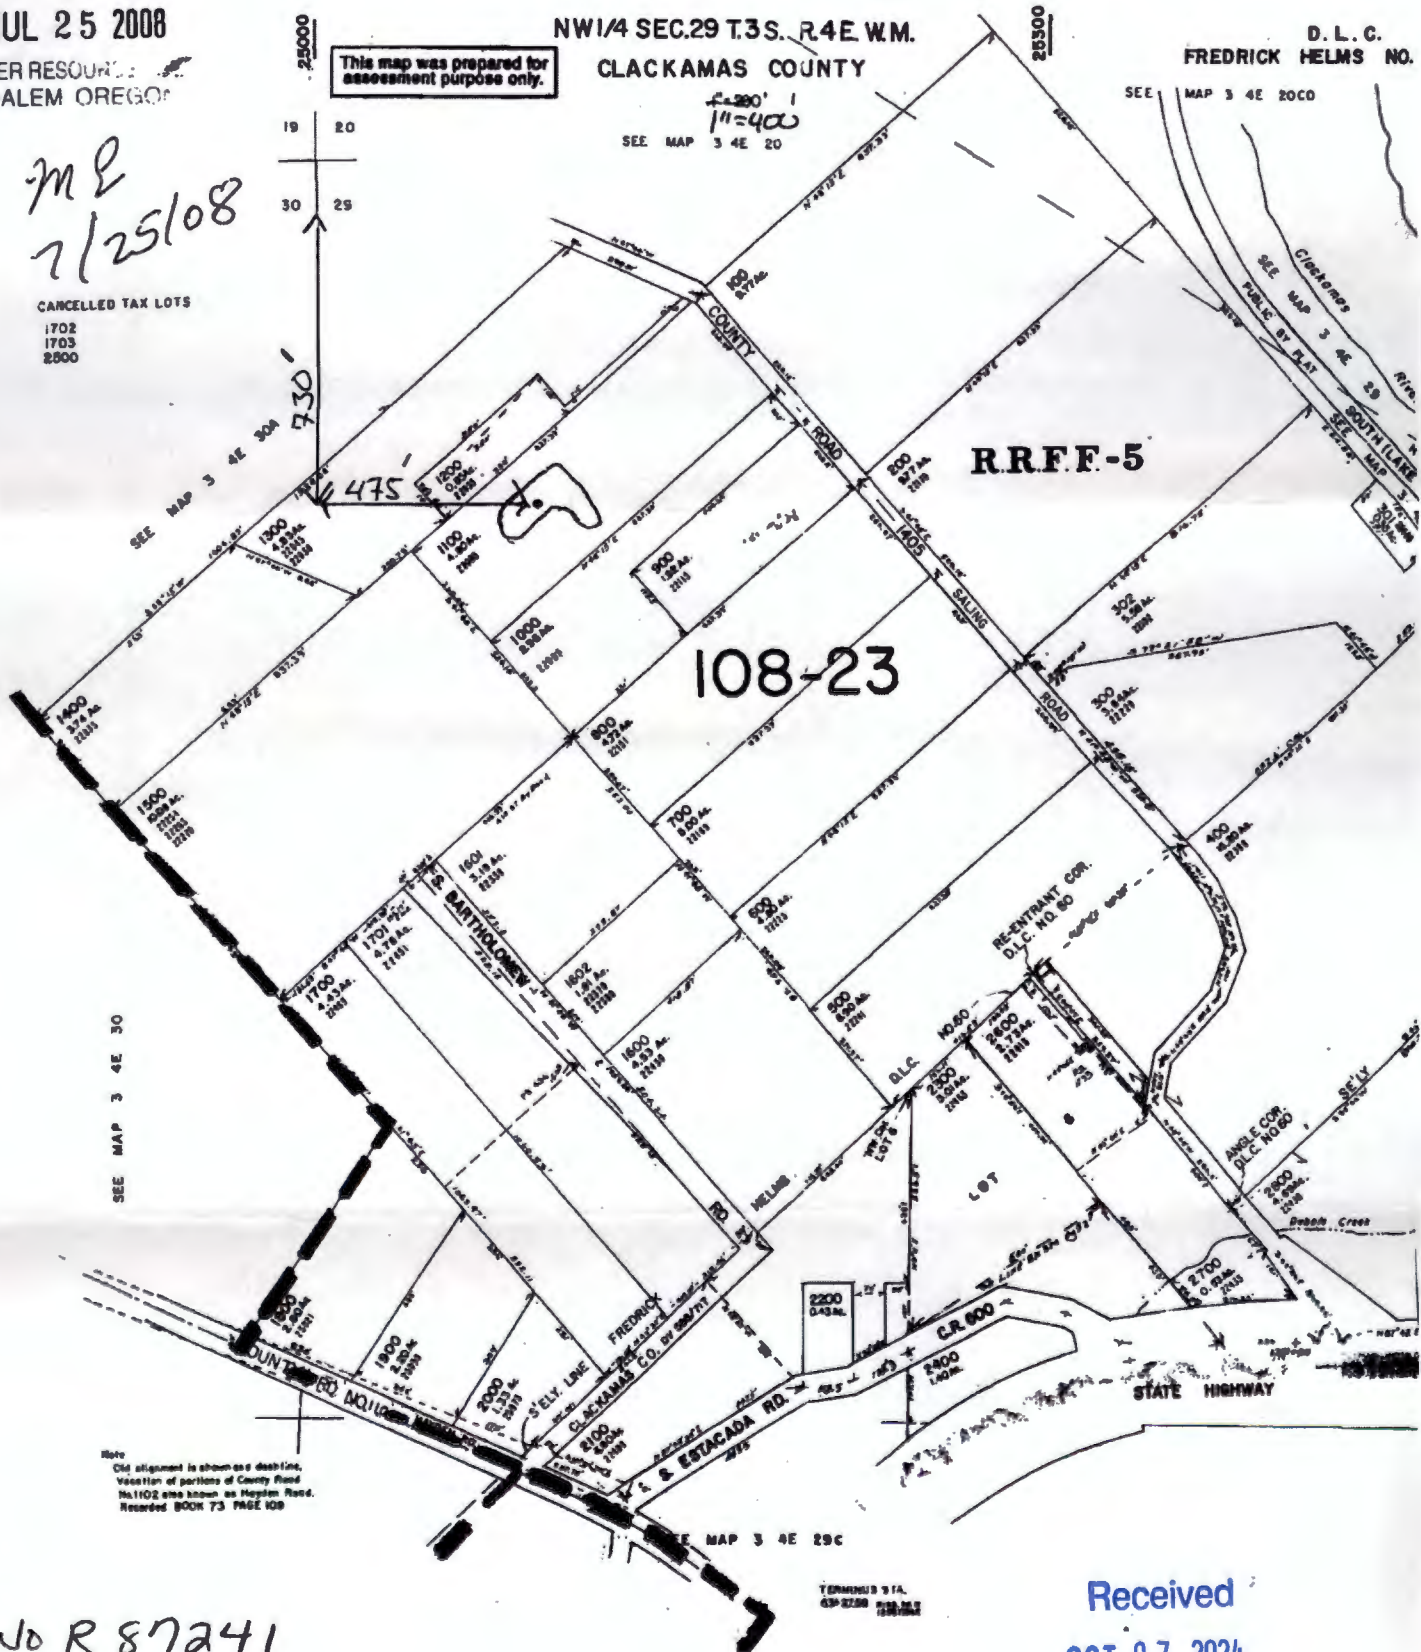

App No R 87241

Received
OCT 07 2024

OWRD