



Certified Water Right Examiner
 381 WRE
Robert D. Pankraz
 Robert D. Pankraz
 May 11, 1994
 STATE OF OREGON

RECEIVED
 FEB 28 2000
 WATER RESOURCES DEPT
 SALEM, OR

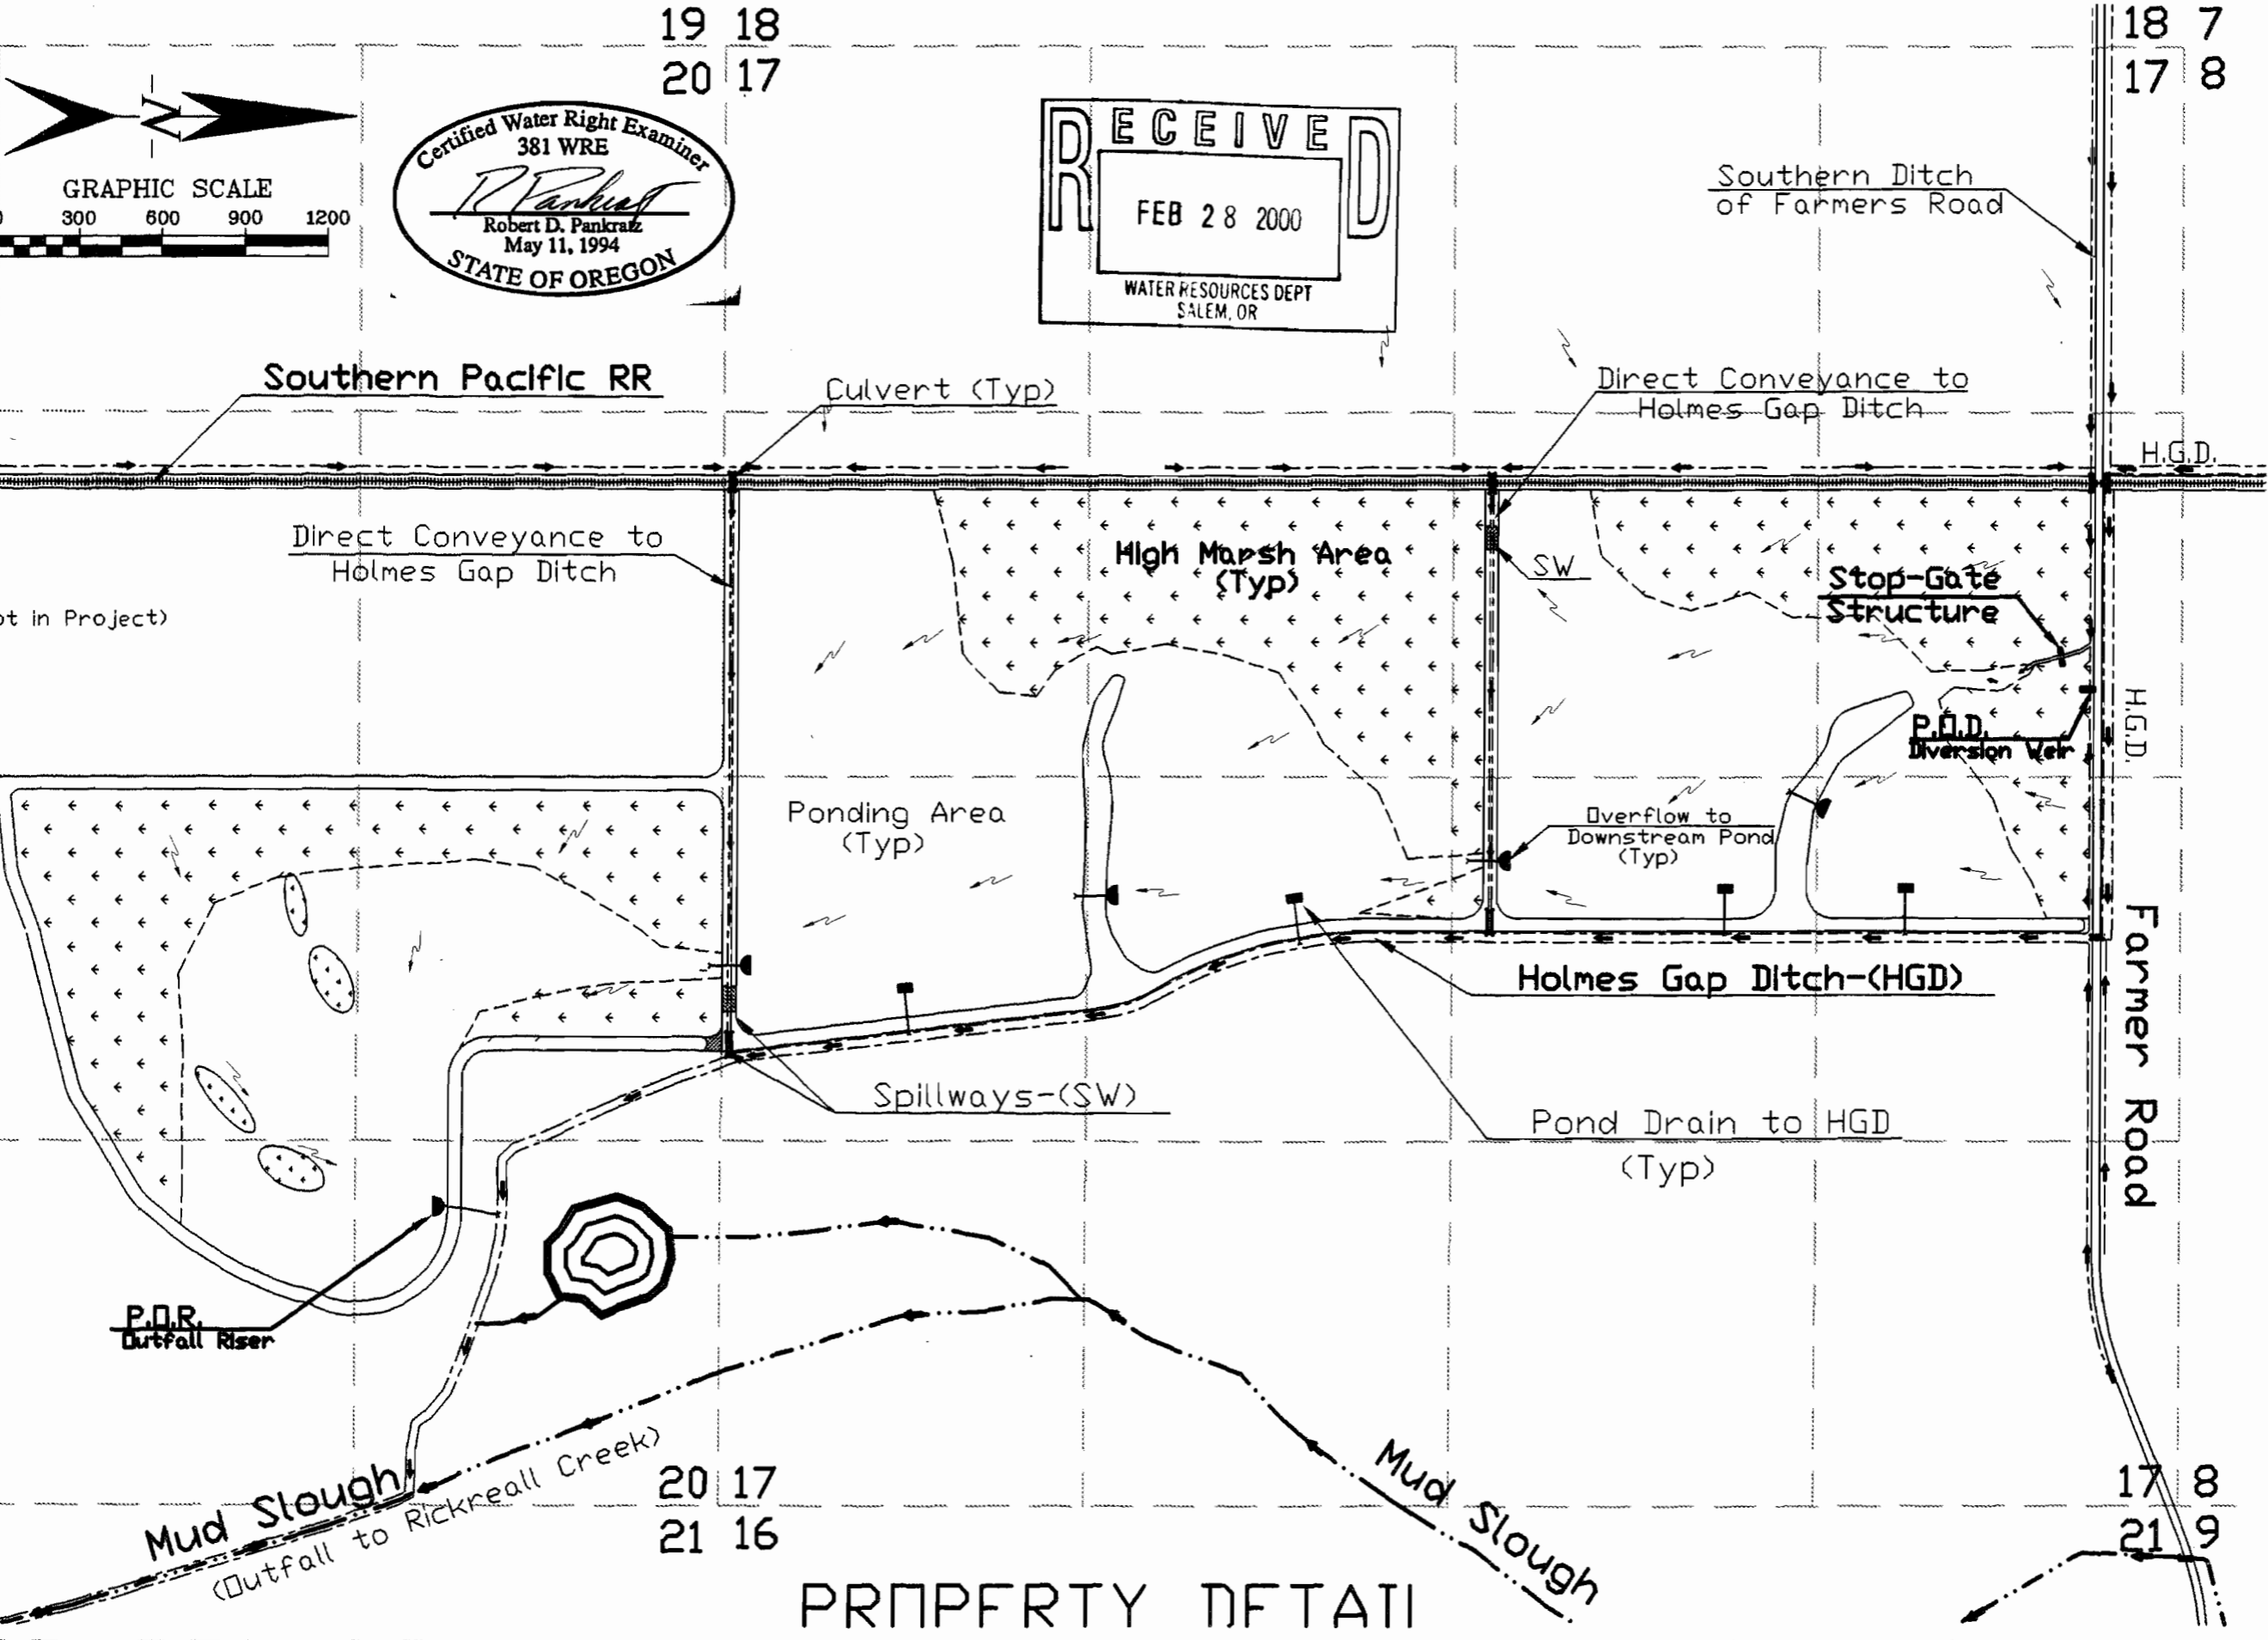

PIONEER ENGINEERING CORP.
 1505 SEATTLE SLEW DR. SE, SALEM OR. 97301
 (503)391-2349 FAX (503)391-2687

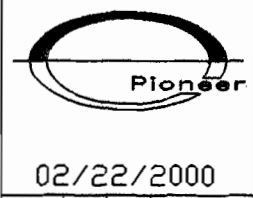

Mark Knaupp Water Right
 T7N, R4W, Sec. 17 & 20
 Polk County, Oregon
 Final Proof Map

PROPERTY OF TATI