


LEGEND

- Point of Diversion (POD)
- Reservoir
- Conveyance Line
- Place of Use (POU)
- All Other Features**
- Tax Lot
- Major Road
- Watercourse


Claim of Beneficial Use Map
Avion Water Company, Inc.
Application G-12757, Permit G-12330
 Township 14 South, Range 12 East (W.M.)

CERTIFIED WATER RIGHTS EXAMINER STAMP

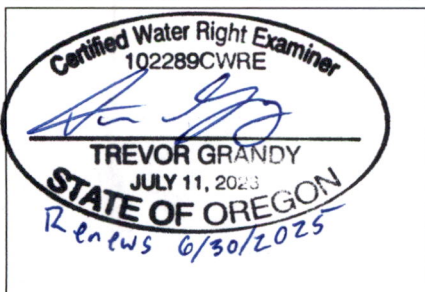

Received
 OCT 07 2024
 OWRD

LOCATION DESCRIPTION
Point of Diversion
 Located 1,476 feet North and 1,707 feet West from the S 1/4 corner of Section 23, Township 14 South, Range 12 East (W.M.)

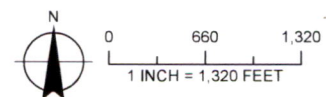

DISCLAIMER
 This map was prepared for the purpose of identifying the location of a water right only and it is not intended to provide legal dimensions or location of property ownership lines.

Date: June 20, 2024
 Data Sources: BLM, ESRI, OWRD, USGS

