

**LEGEND**


- Permit G-9398 POU
- Tax Lot
- Government Lot (GL)
- Watercourse

**Claim of Beneficial Use  
Avion Water Co. Inc.  
Place of Use**

**Transfer T-12732, Permit G-9398**

Township 15 South, Range 14/15 East (W.M.)


**CERTIFIED WATER RIGHTS EXAMINER STAMP**

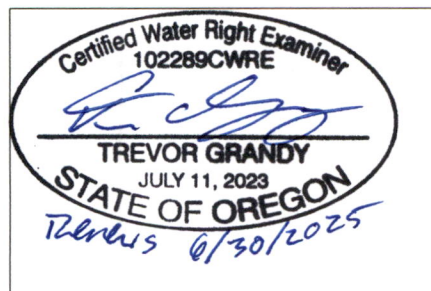


Received  
OCT 07 2024  
OWRD

**DISCLAIMER**  
This map was prepared for the purpose of identifying the location of a water right only and it is not intended to provide legal dimensions or location of property ownership lines.

Date: September 24, 2024  
Data Sources: BLM, ESRI, OWRD, USGS

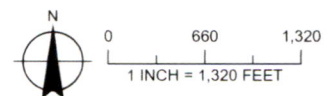

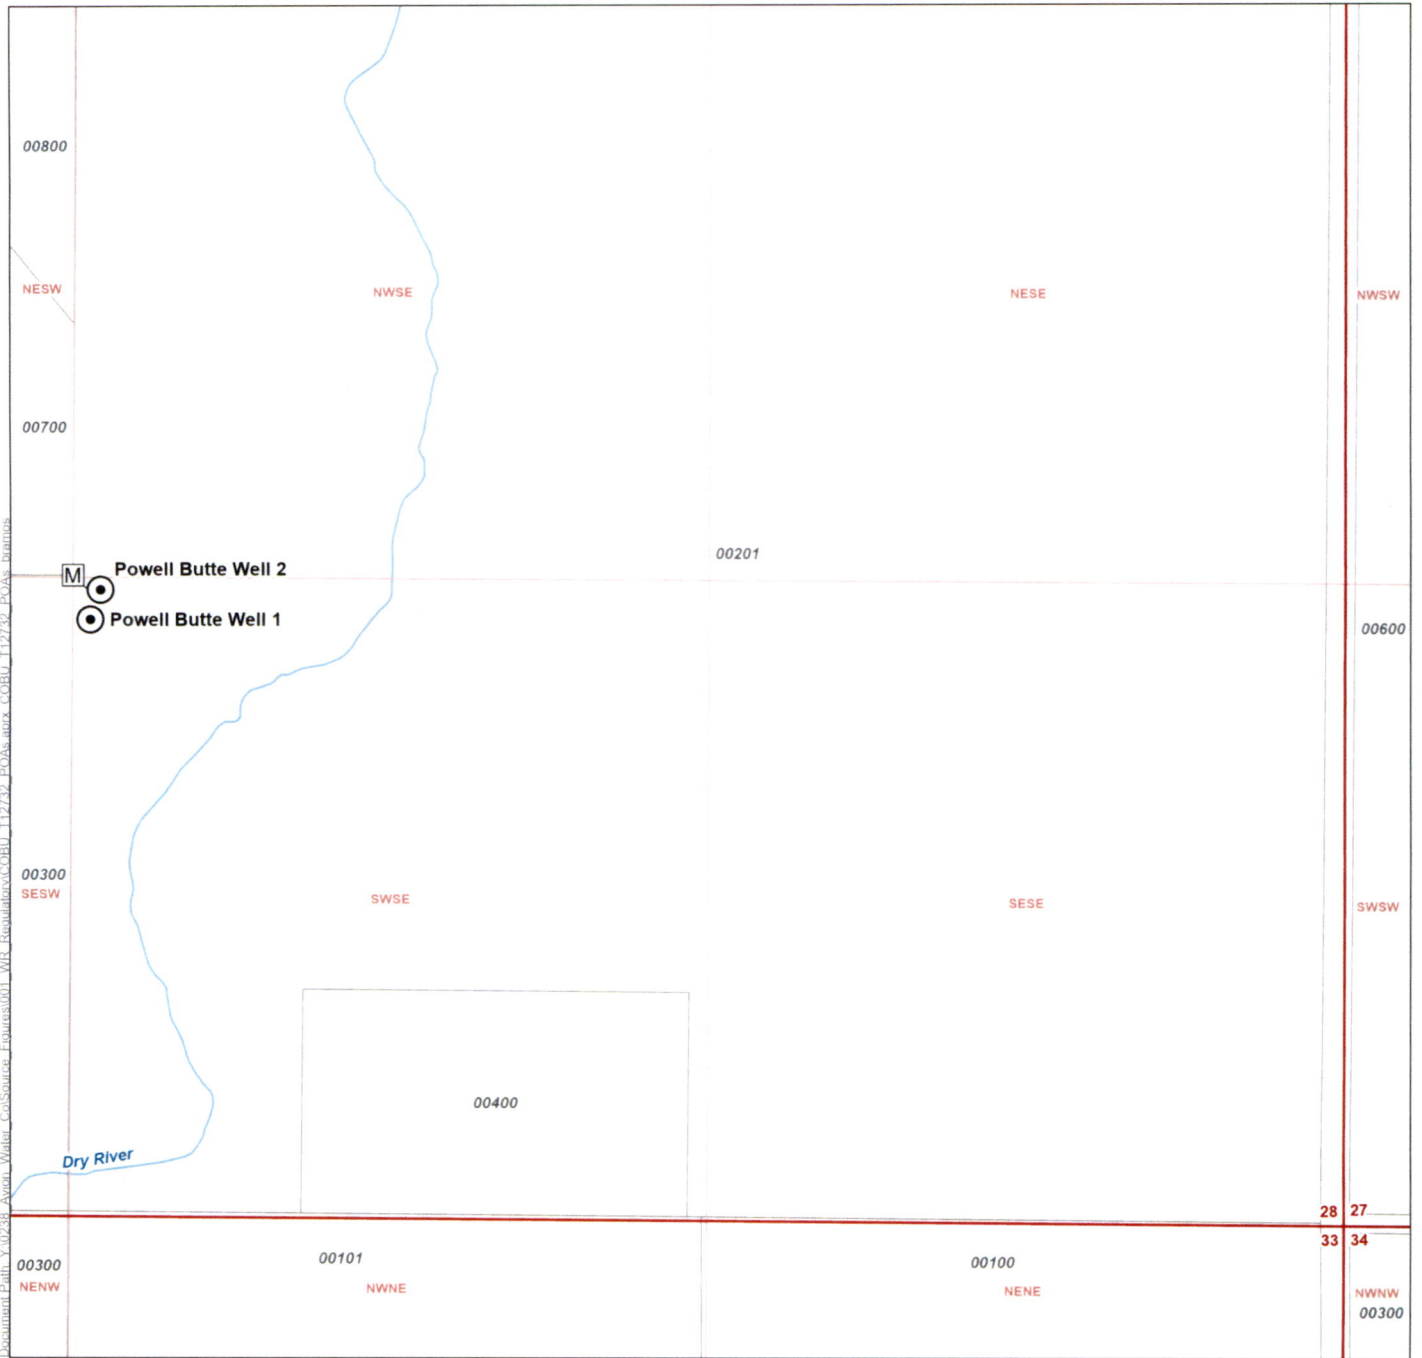


**LEGEND**

- Point of Appropriation (POA)
- Flow Meter
- Tax Lot
- Watercourse

**Claim of Beneficial Use**  
**Avion Water Co. Inc.**  
**Points of Appropriation Map**  
**Transfer T-12732, Permit G-9398 and G-12936**  
 Township 15 South, Range 14 East (W.M.)

Received  
 OCT 07 2024  
 OWRD

**CERTIFIED WATER RIGHTS EXAMINER STAMP**

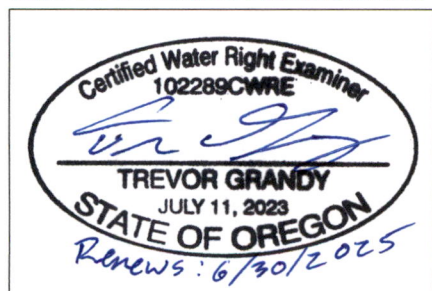

**LOCATION DESCRIPTION**

**Powell Butte Well 1**  
 SW ¼, SE ¼ of Section 28, T 15 S, R 14 E, WM 88.95 Feet South and 38.27 Feet East from the NW corner of the SW ¼ of the SE ¼ of Section 28

**Powell Butte Well 2**  
 SW ¼, SE ¼ of Section 28, T 15 S, R 14 E, WM 23.33 Feet South and 62.6 Feet East from the NW corner of the SW ¼ of the SE ¼ of Section 28

**DISCLAIMER**  
 This map was prepared for the purpose of identifying the location of a water right only and it is not intended to provide legal dimensions or location of property ownership lines.

Date: September 26, 2024  
 Data Sources: BLM, ESRI, OWRD, USGS

