


CLAIM of BENEFICIAL USE MAP

FOR: POOPAK DOKHANCHI
 BY: NATHAN REED, PE, CWRE
 T26S, R4W, W.M. SECTION 13
 APPLICATION NO. S-72929
 PERMIT NO. S-51808



SCALE: 1" = 400'

DATE OF SURVEY: AUGUST 8, 2024

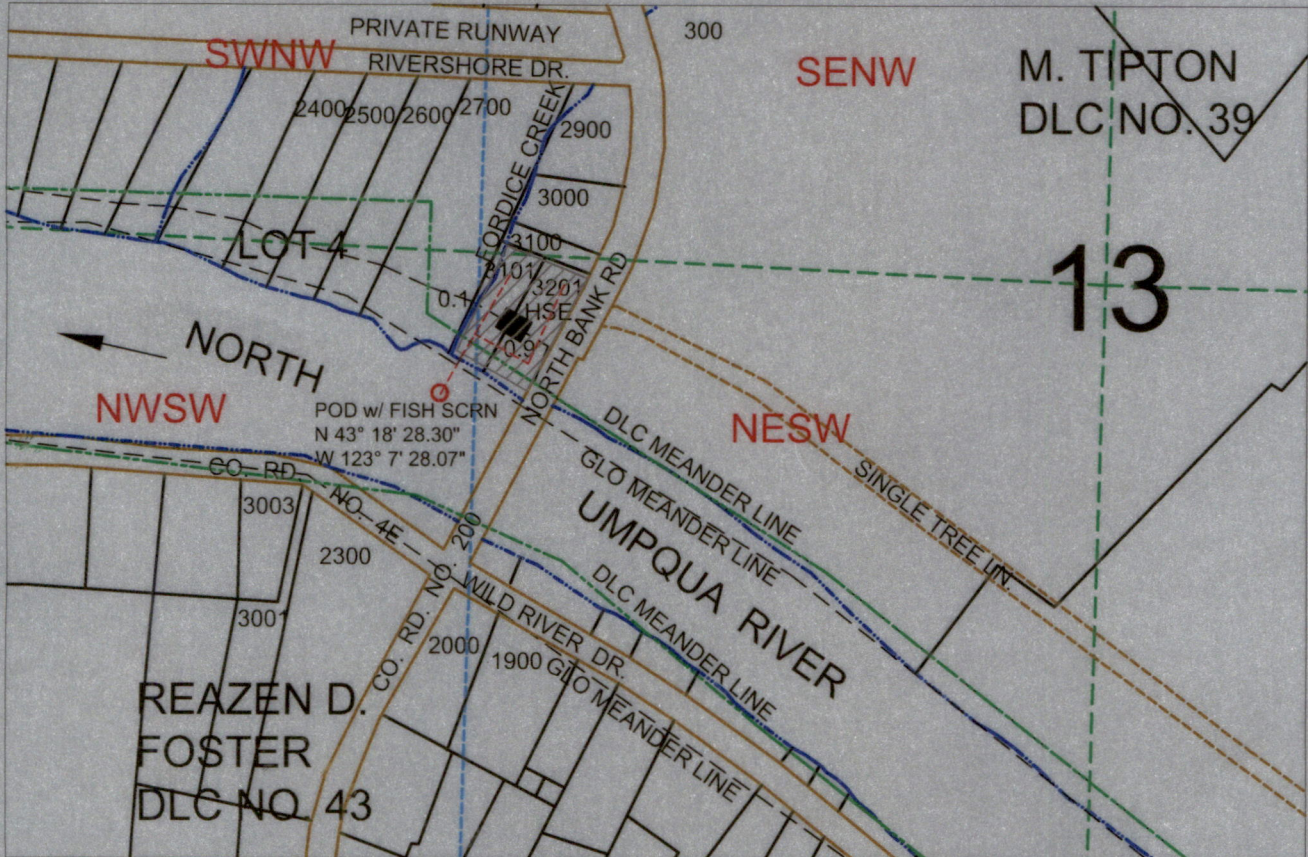








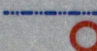


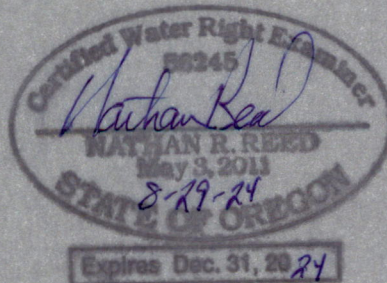
POD IS LOCATED 297 FEET SOUTH & 1380 FEET WEST OF C1/4 CORNER OF SECTION 13 .

Received
 OCT 09 2024
 OWRD

Received
 SEP 09 2024
 OWRD

LEGEND

-  WATER
-  POD
-  WATERLINE
-  SECTION
-  QUARTER
-  SIXTEENTH
-  DLC
-  GLOT
-  PARCEL
-  IRRIGATION AREA



MAP PREPARED FOR:
 POOPAK DOKHANCHI
 14341 SAN PABLO AVE
 SAN PABLO, CA 94806

MAP PREPARED BY:
 NATHAN REED PE, CWRE
 157 WEST BODIE STREET
 ROSEBURG, OR 97471

THE PURPOSE OF THIS MAP IS TO IDENTIFY THE LOCATION OF THE WATER RIGHT. IT IS NOT INTENDED TO PROVIDE INFORMATION RELATIVE TO THE LOCATION OF PROPERTY OWNERSHIP BOUNDARY LINES.