


**T 18S R 46E WM**

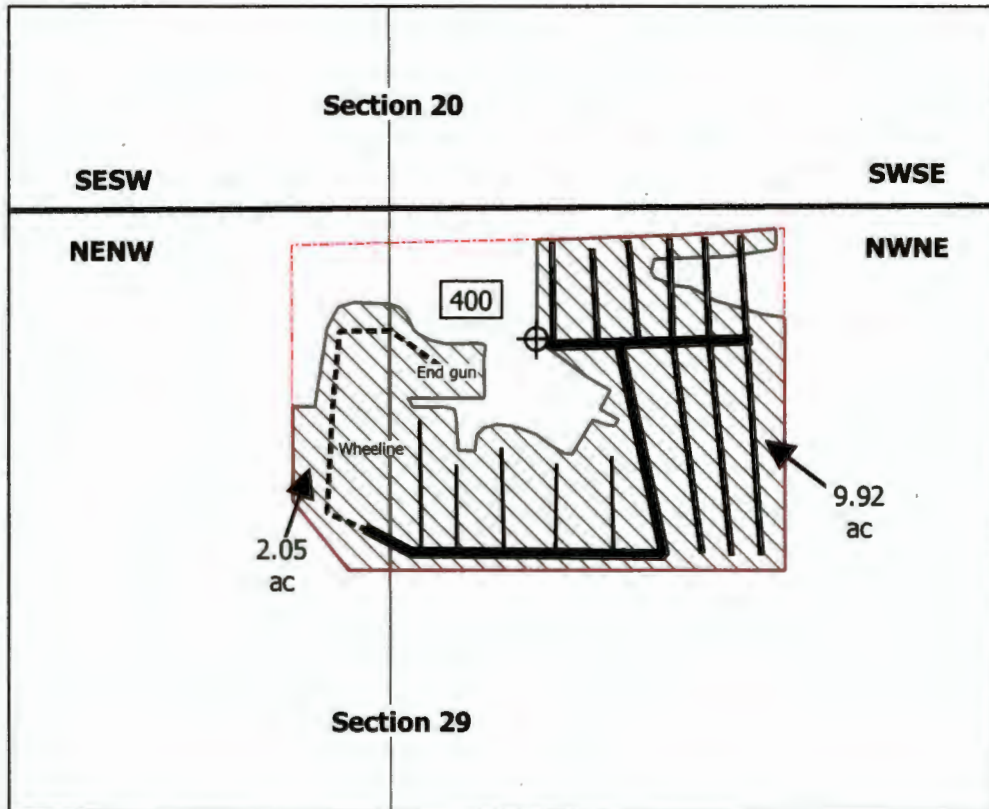

**LEGEND**

- Well
- Place of Use
- Malheur County Property Boundary 400
- 2" Lateral
- 3" Handline
- 3" Lateral
- 4" Mainline

Received

OCT 15 2024

OWRD



**Claim of Beneficial Use Map  
Application G-18654, Permit G-18247  
Malheur County, OR**

Prepared on behalf of Vern and Amelia Keffer

1 inch = 400 feet



**Notes:**

Well 2 (L-126977): 330' South and 2,226' west from the NE corner of Section 29

Flow measurement device located within a 5 foot radius of Well 2

This map is not intended to provide legal dimensions or locations of property ownership lines.