


LEGEND

-  RESERVOIR NOT ON QUAD
-  RESERVOIR SHOWN ON QUAD
-  ROAD
-  CHANNEL
-  TRAIL
-  COUNTY LINE
-  MINE
-  FD SEC COR
-  SPRING

CLAIM OF BENEFICIAL USE MAP

U.S.G.S. QUAD - MORMON BASIN, OREG. - 7 1/2'

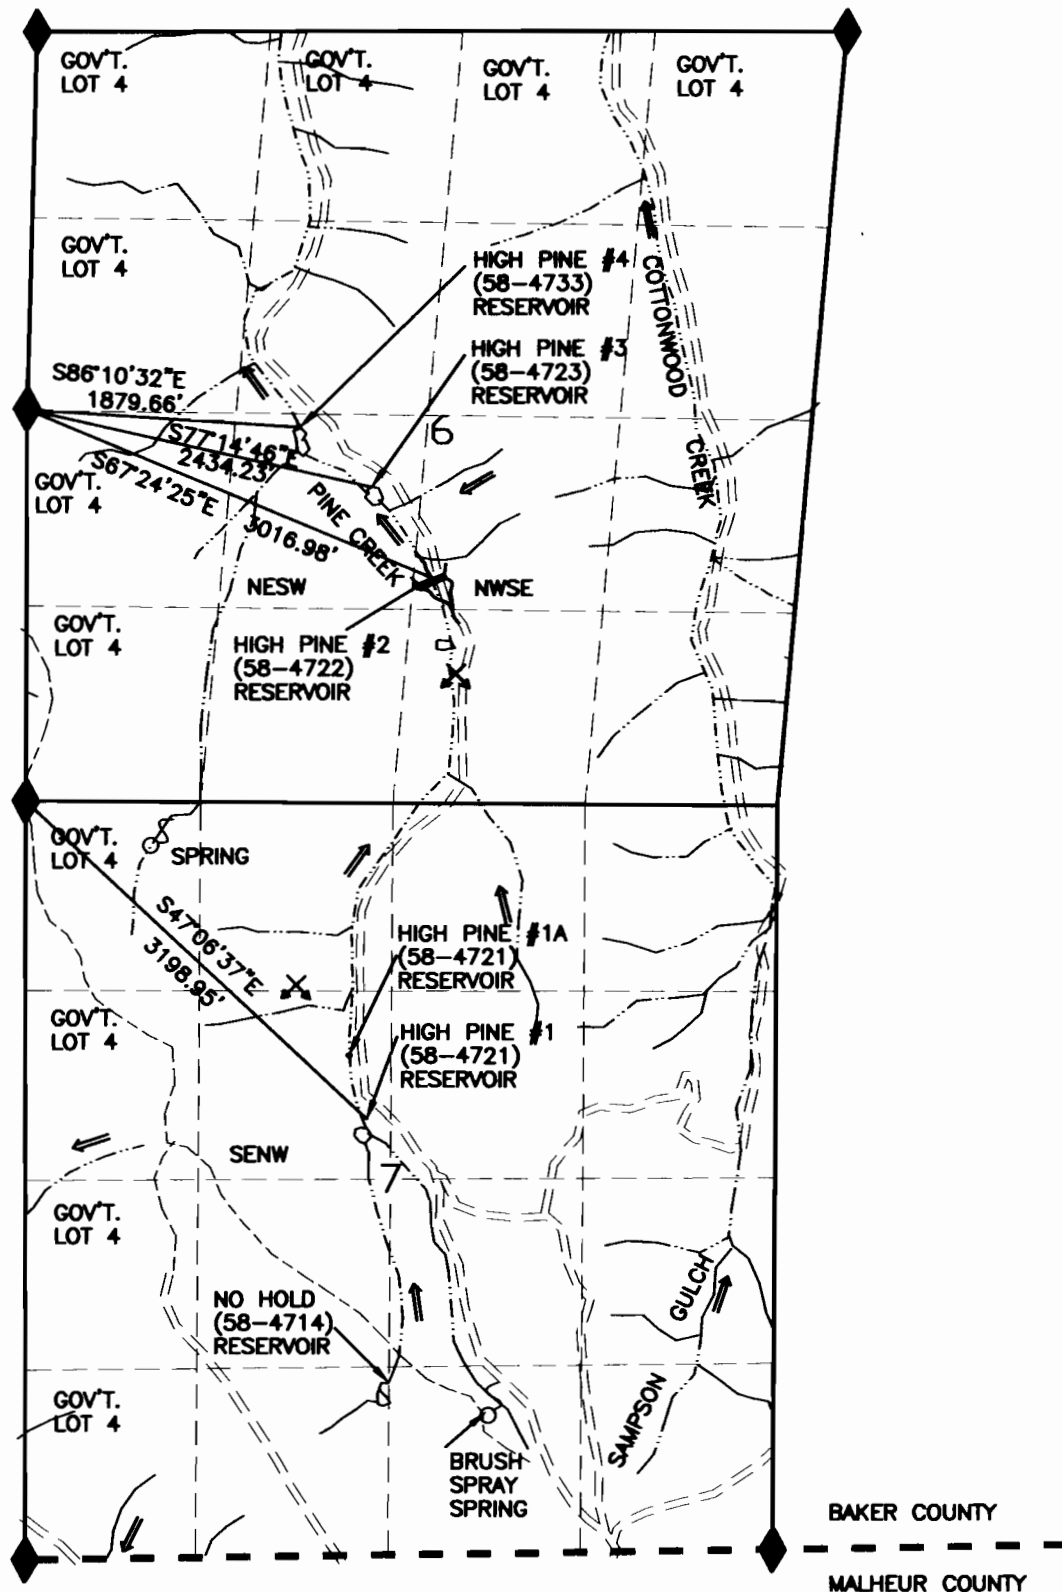

APPLICATION R-82519 ; PERMIT R-12275
HIGH PINE #1 & HIGH PINE #1A (58-4721) RESERVOIRS
SE1/4 NW1/4 SECTION 7, T.13S., R.42E., W.M.
S47°06'37"E, 3198.95' FROM THE NW COR OF SAID SECTION 7

I, James R. Pritchard Acting ADM Operations/Field Services agree to the findings of the CWRE and do submit this site report and map as my Claim of Beneficial Use of the water as provided under the terms and conditions of my Permit R-12275

APPLICATION R-82520 ; PERMIT R-12276
HIGH PINE #2 (58-4722) RESERVOIR
NW1/4 SE1/4 SECTION 6, T.13S., R.42E., W.M.
S67°24'25"E, 3016.98' FROM THE W1/4 COR OF SAID SECTION 6


I, James R. Pritchard Acting ADM Operations/Field Services agree to the findings of the CWRE and do submit this site report and map as my Claim of Beneficial Use of the water as provided under the terms and conditions of my Permit R-12276

APPLICATION R-82521 ; PERMIT R-12277
HIGH PINE #3 (58-4723) RESERVOIR
NE1/4 SW1/4 SECTION 6, T.13S., R.42E., W.M.
S77°14'46"E, 2434.23' FROM THE W1/4 COR OF SAID SECTION 6

I, James R. Pritchard Acting ADM Operations/Field Services agree to the findings of the CWRE and do submit this site report and map as my Claim of Beneficial Use of the water as provided under the terms and conditions of my Permit R-12277

APPLICATION R-82522 ; PERMIT R-12278
HIGH PINE #4 (58-4733) RESERVOIR
NE1/4 SW1/4 SECTION 6, T.13S., R.42E., W.M.
S86°10'32"E, 1879.65' FROM THE W1/4 COR OF SAID SECTION 6

I, James R. Pritchard Acting ADM Operations/Field Services agree to the findings of the CWRE and do submit this site report and map as my Claim of Beneficial Use of the water as provided under the terms and conditions of my Permit R-12278

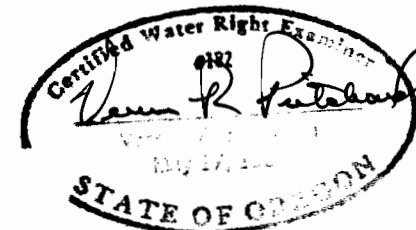

Expires 12/31/02



REV. NO.	DESCRIPTION	DATE	APPROVED
	UNITED STATES DEPARTMENT OF THE INTERIOR BUREAU OF LAND MANAGEMENT		
	DIVISION OF OPERATIONS		OREGON STATE OFFICE
	BAKER RESOURCE AREA RESERVOIRS IN SEC 6 & 7, T.13S., R.42E., W.M.		
	HIGH PINE #1-#4 RESERVOIRS		
DESIGNED	<u>James R. Pritchard</u>		
REVIEWED	<u>James R. Pritchard</u>		
APPROVED	<u>James R. Pritchard</u>		
DRAWN: C.G.	SCALE: 1"=1320'		
DATE: 08/18/01	SHEET 1 OF 1		
DRAWING NO. OR-03-917245-1084			

1320 660 0 1320

SCALE 1"=1320'

THIS MAP IS FOR THE PURPOSE OF LOCATING A WATER RIGHT AND IS NOT INTENDED TO PROVIDE LEGAL DIMENSIONS FOR LOCATION OF PROPERTY BOUNDARIES.