


CENTER OF POND IS 615' N. OF THE DOUTH-MOST QUINE OF SECTION 28, ON THE QQ LINE 9882 PATING THE 9.2. Q

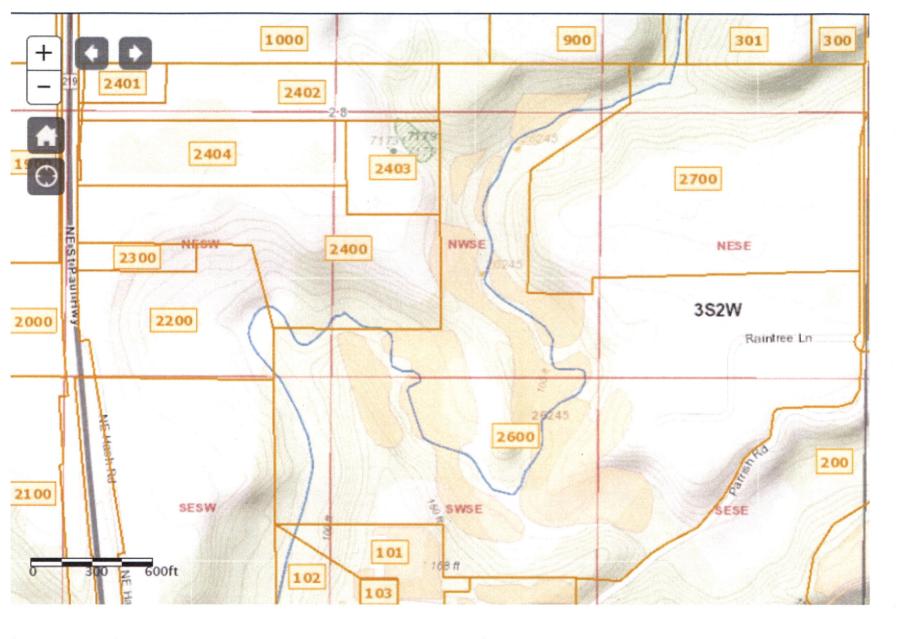

Received OCT 2 1 2024 OWRD