


Claim of Beneficial Use  
 C & E Brentano Family LP / RD Farms Inc.  
 Transfer T-12917



Township 4S, Range 2W, W.M.

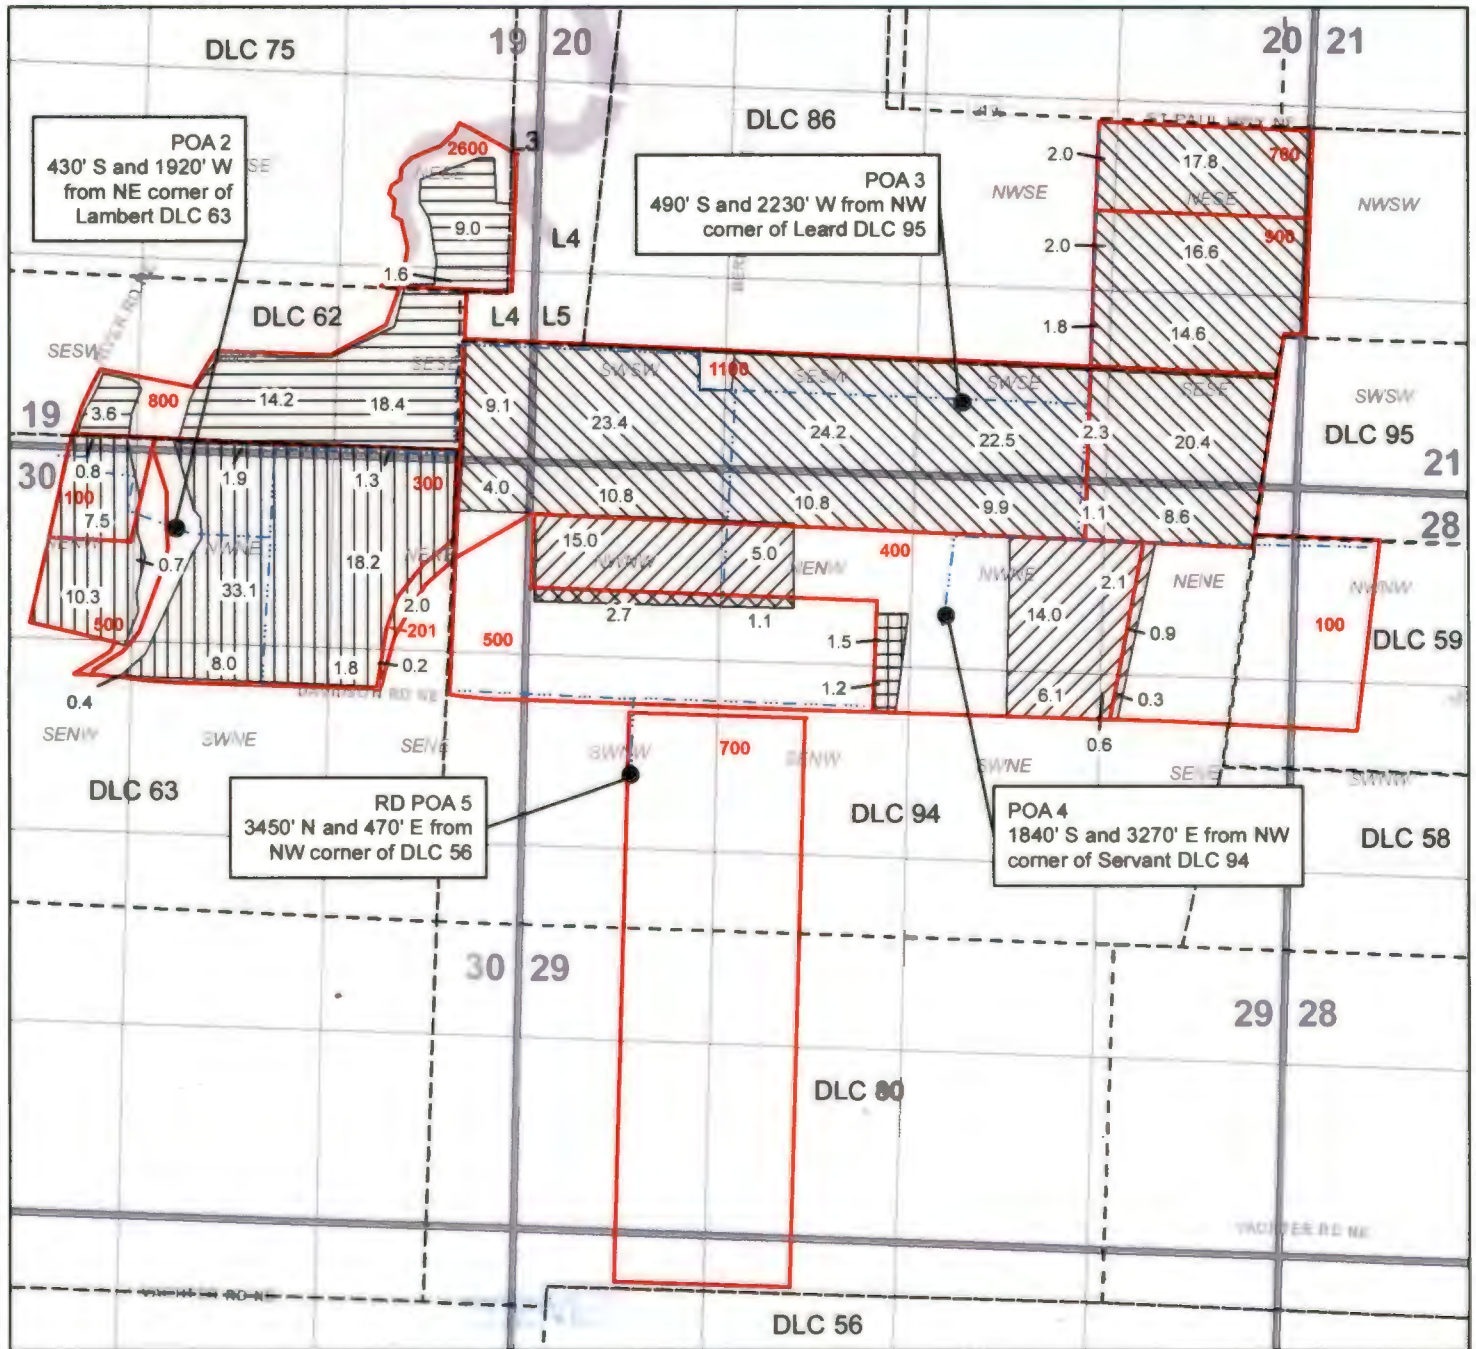

This map is not intended to provide legal dimensions or locations of property ownership lines.

Legend

- T-12917 POU (94734 CN, POA 3, 4)
- T-12917 POU (35370 CN, POA 2, 3, 4)
- T-12917 POU (40094 CN, RD POA 5)
- T-12917 POU (40094 CN, POA 3, 4)
- T-12917 POU (35497 CN, POA 3, 4)
- T-12917 POU (35496 CN, POA 3, 4)
- Mainline
- DLC
- Taxlots

Received by DWARD  
 OCT 23 2024  
 Salem, OR



EXPIRES: 12-31-2024