

RECEIVED  
OCT 26 2024  
OWRD

# CLAIM OF BENEFICIAL USE MAP FOR D JACK FLYNN

SECTION 21, T36S R24E W.M.  
LAKE COUNTY, OREGON


## LEGEND

- SECTION LINE
- 1/4 SECTION LINE
- 1/16 SECTION LINE
- MAINLINE

APPLICATION NO. G-17914  
PERMIT NO. G-17410



SCALE: 1"=1320'

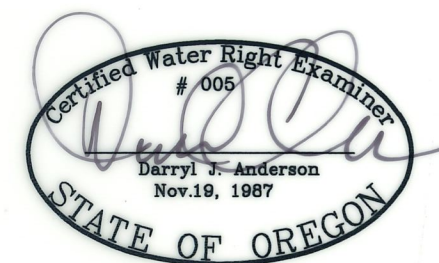

RENEWAL 12/31/25

NOTE:  
PREPARATION OF THIS MAP IS FOR IDENTIFYING WATER RIGHTS ONLY. IT  
HAS NO INTENT TO PROVIDE LOCATIONS OR DIMENSIONS OF PROPERTY  
BOUNDARIES.

REVISION	BY

ANDERSON ENGINEERING  
AND SURVEYING, INC.  
P.O. BOX 28  
LAKEVIEW, OREGON 97630  
(541) 947-4407/FAX: 947-2321  
WWW.ANDERSONENGINEERING.COM

FOR:  
JACKIE MATHIS  
28571 HOGBACK ROAD  
PLUSH, OR 97687  
541-947-2463

CLAIM OF BENEFICIAL MAP  
PERMIT G-17410  
SECTION 21, T36S, R24E W.M.

DATE:	5/22/2024
SCALE:	1" = 1320'
DWG. BY:	R.C.
JOB:	2021-179
FILE:	2021-179
SHEET:	1 OF 1