


Claim of Beneficial Use - Phan


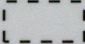
 
 
Application G-17423, Permit G-16867

Township 7S, Range 2W, Section 20, W.M.

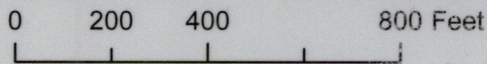

This map is not intended to provide legal dimensions or locations of property ownership lines.

Legend

-  IR POU
-  DLC
-  Mainline
-  Taxlot 2000



Received by OWRD

EXPIRES: 12-31-2024

OCT 28 2024

Salem, OR