

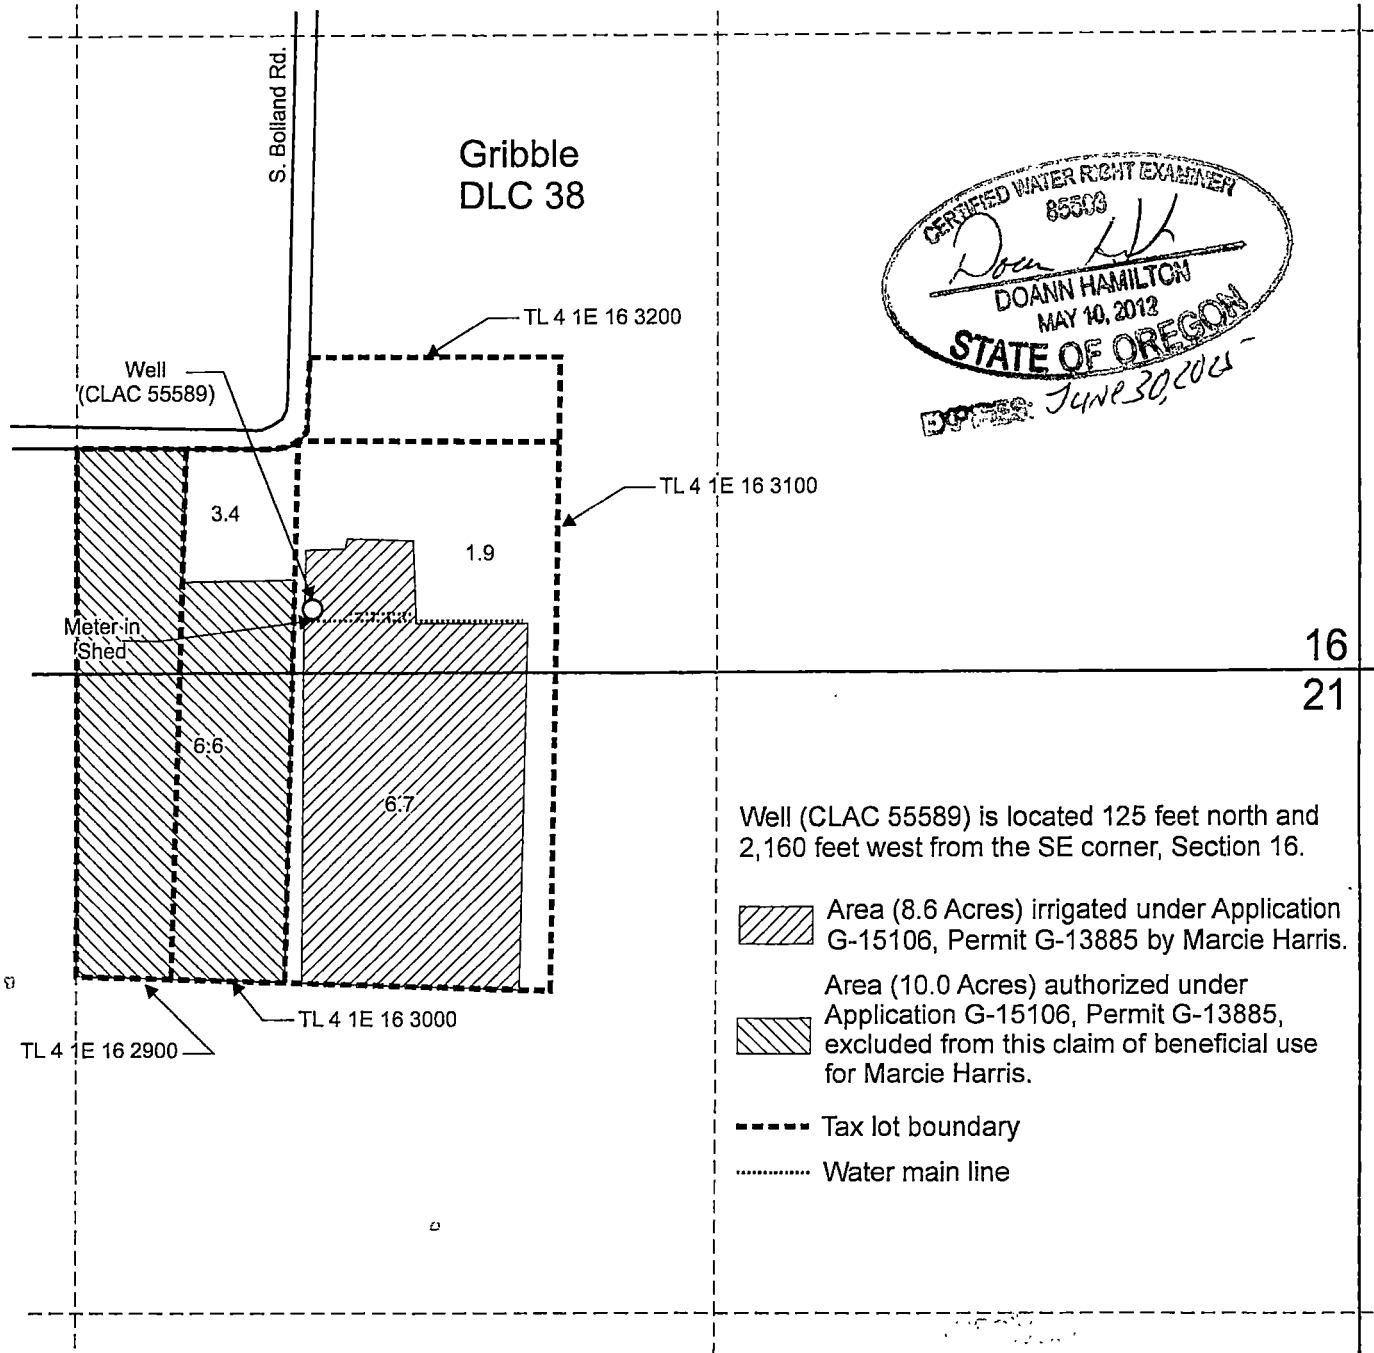


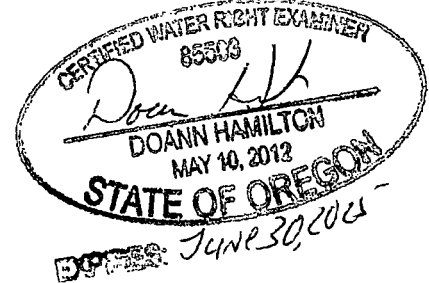


# T.4S. R.1E. Sec. 16 & 21, W.M.

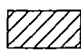


16  
21

Well (CLAC 55589) is located 125 feet north and 2,160 feet west from the SE corner, Section 16.

-  Area (8.6 Acres) irrigated under Application G-15106, Permit G-13885 by Marcie Harris.
-  Area (10.0 Acres) authorized under Application G-15106, Permit G-13885, excluded from this claim of beneficial use for Marcie Harris.
-  Tax lot boundary
-  Water main line

Scale: 1" = 400'

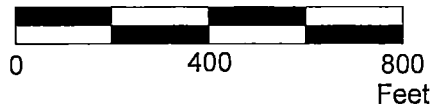

This map was prepared for the purpose of identifying the location of a water right only and is not intended to provide legal dimensions or location of property ownership lines.



**Claim of Beneficial Use Map**  
Application G-15106, Permit G-13885

Marcie Harris.  
T.4S. R.1E. Sec. 16 & 21, W.M.

Pacific Hydro-Geology Inc.

10/2024