


CLAIM OF BENEFICIAL USE MAP

TO CHANGE PLACE OF USE AND ADD A POINT OF APPROPRIATION
PER T-13925 FOR GOLDEN RULE FARMS, INC.


SECTION 1, TOWNSHIP 27 SOUTH, RANGE 31 EAST, W.M.
TAX LOTS: 200 & 300
SECTION 6, TOWNSHIP 27 SOUTH, RANGE 32 EAST, W.M.
TAX LOTS: 900 & 1000

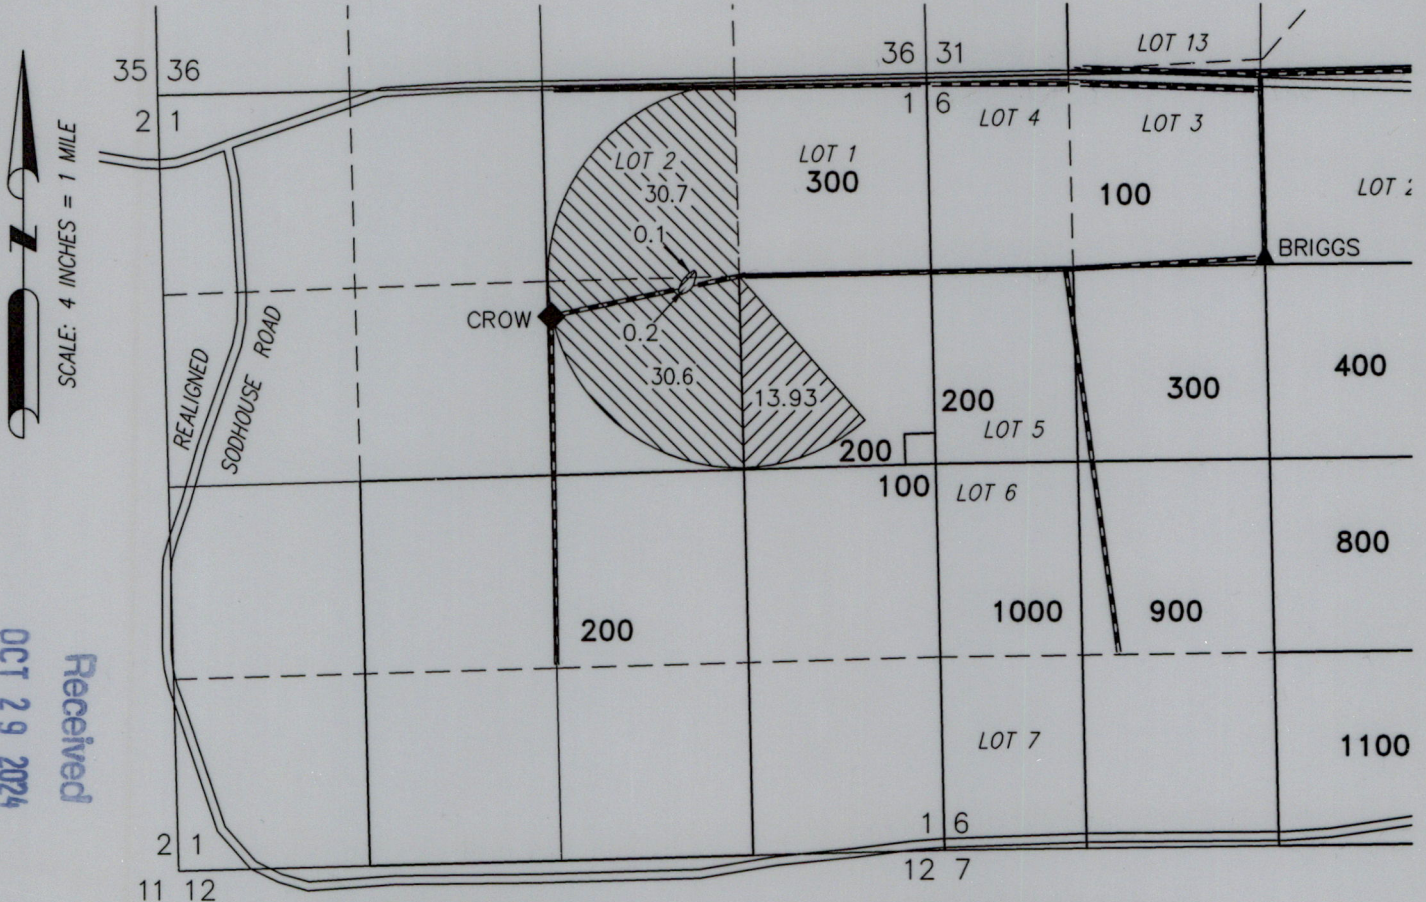

Received
 OCT 29 2024
 OWRD

◆ **WELL 3 CROW (HARN 1461)**
 LOCATED IN THE SW 1/4 NE 1/4 SECTION 1, T27S
 R31E, W.M. AND 1542 FEET SOUTH AND 21 FEET EAST
 FROM THE N 1/4 CORNER OF SECTION 1.
 FLOW METER IS LOCATED 4.0' SOUTH FROM WELL.

▲ **WELL 2 BRIGGS (HARN 1460)**
 LOCATED IN THE NE 1/4 NW 1/4 LOT 3) SECTION 6,
 T27S R32E, W.M. AND 1280 FEET SOUTH AND 1 FEET
 WEST FROM THE N 1/4 CORNER OF SECTION 6.
 FLOW METER IS LOCATED 4.0' WEST FROM WELL.

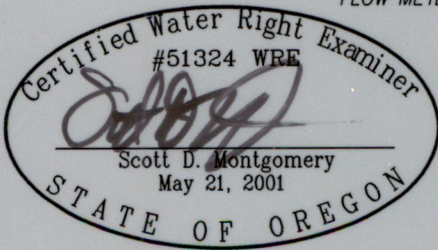

- 14.23 ACRES IR FROM WELLS 2 & 3 (G-1463), AS SHOWN.
- 61.3 ACRES IR FROM WELLS 2 & 3 (G-13639), AS SHOWN.

THIS MAP IS FOR THE PURPOSE OF LOCATING A WATER RIGHT ONLY AND HAS NO INTENT TO PROVIDE LEGAL DIMENSIONS OR THE LOCATION OF PROPERTY LINES.

RENEWAL DATE: 12/31/2024

PREPARED FOR:

GOLDEN RULE FARMS, INC.
 P.O. BOX 255
 CHRISTMAS VALLEY, OR 97641

PREPARED BY:



ALL POINTS ENGINEERING AND SURVEYING, INC.
 P.O. BOX 767 TERREBONNE, OR 97760
 (541) 548-5833 www.APEandS.com