

# CLAIM OF BENEFICIAL USE MAP


TO CHANGE PLACE OF USE AND POINT OF APPROPRIATION  
PER T-12822 FOR GOLDEN RULE FARMS, INC.

SECTION 1, TOWNSHIP 27 SOUTH, RANGE 31 EAST, W.M.

TAX LOTS: 200 & 300

SECTION 6, TOWNSHIP 27 SOUTH, RANGE 32 EAST, W.M.


TAX LOTS: 900 & 1000

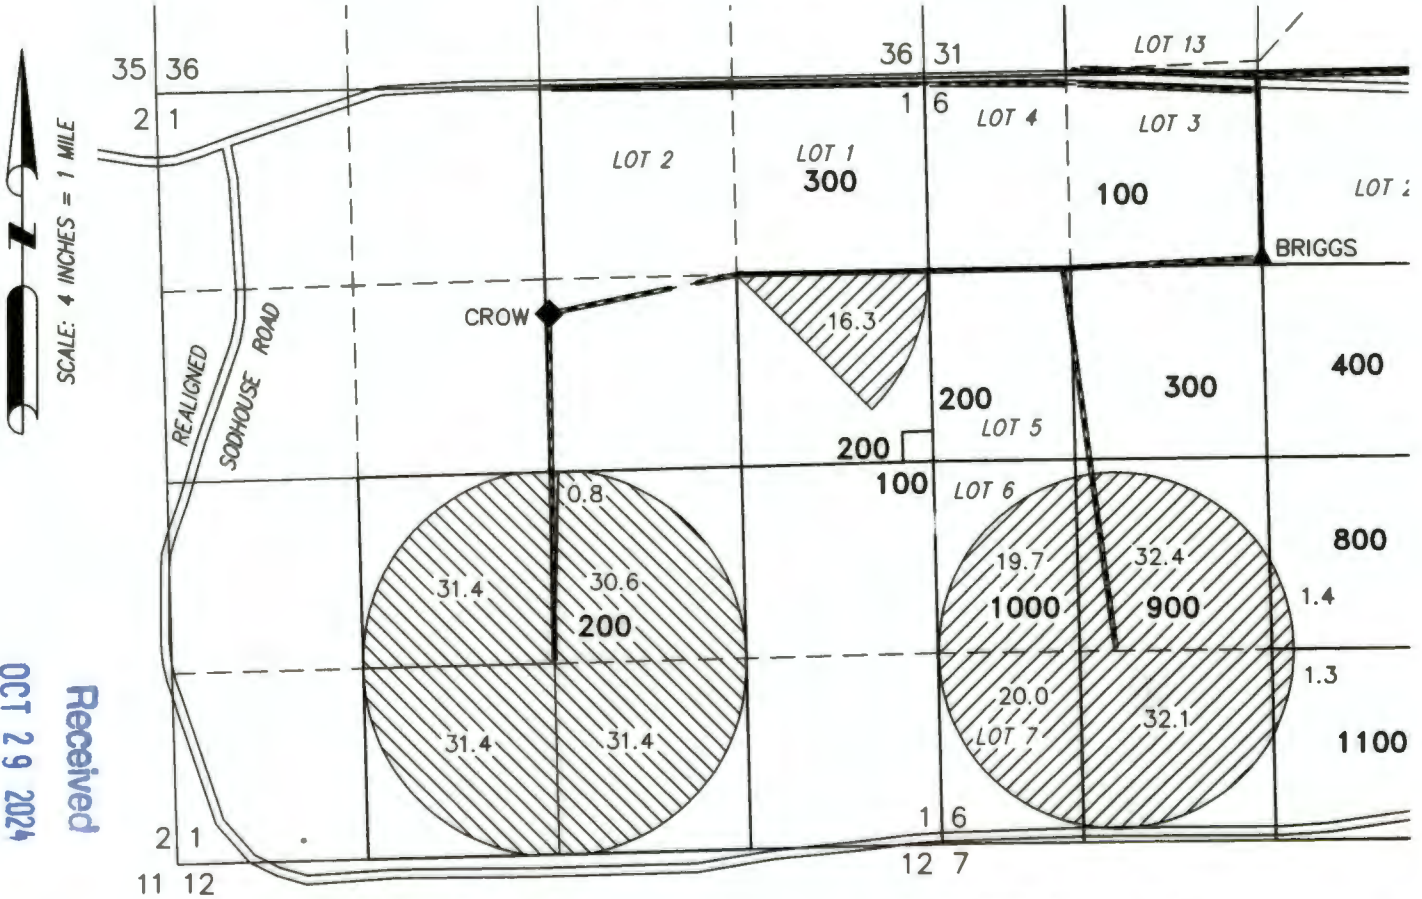

Received  
 OCT 29 2024  
 OWRD

◆ **WELL 3 CROW (HARN 1461)**  
 LOCATED IN THE SW 1/4 NE 1/4 SECTION 1, T27S  
 R31E, W.M. AND 1542 FEET SOUTH AND 21 FEET EAST  
 FROM THE N 1/4 CORNER OF SECTION 1.  
 FLOW METER IS LOCATED 4.0' SOUTH FROM WELL.

▲ **WELL 2 BRIGGS (HARN 1460)**  
 LOCATED IN THE NE 1/4 NW 1/4 LOT 3) SECTION 6,  
 T27S R.32E, W.M. AND 1280 FEET SOUTH AND 1 FEET  
 WEST FROM THE N 1/4 CORNER OF SECTION 6.  
 FLOW METER IS LOCATED 4.0' WEST FROM WELL.

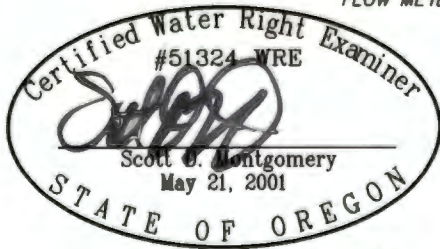

- 124.0 ACRES IR FROM WELLS 2 & 3 (G-17514), AS SHOWN.
- 124.8 ACRES IR FROM WELLS 2 & 3 (G-13639), AS SHOWN.

THIS MAP IS FOR THE PURPOSE OF LOCATING A WATER RIGHT ONLY AND HAS NO INTENT TO PROVIDE LEGAL DIMENSIONS OR THE LOCATION OF PROPERTY LINES.

RENEWAL DATE: 12/31/2024

PREPARED FOR:

GOLDEN RULE FARMS, INC.  
 P.O. BOX 255  
 CHRISTMAS VALLEY, OR 97641

PREPARED BY:



ALL POINTS ENGINEERING AND SURVEYING, INC.  
 P.O. BOX 767  
 TERREBONNE, OR 97760  
 (541) 548-5833  
 www.APEandS.com