


NE NW	NW NE	NE NE	1 6 NW NW
SE NW	SW NE	SE NE	SW NW
NE SW	NW SE	NE SE	NW SW
SE SW	SW SE	SE SE	1 6 SW SW

QUARTER-QUARTER SECTION GUIDE

NTS

T6S R4W, WM
T6S R5W, WM
YAMHILL COUNTY

TAX LOTS:
6.5.01 100
200
300
600
1200

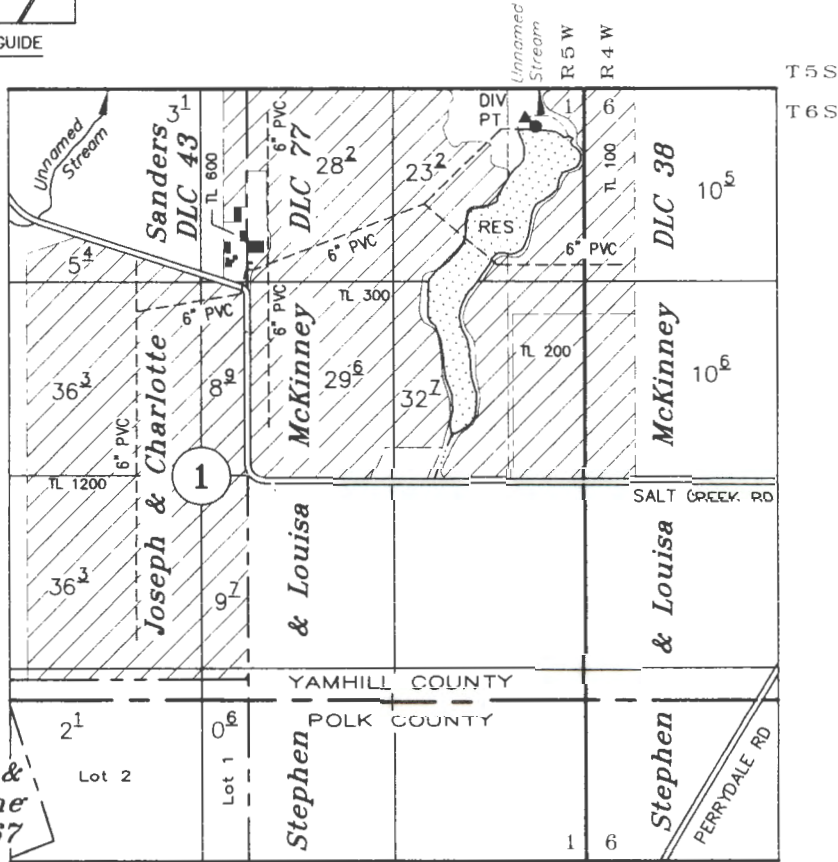

T5S
T6S



- DIV PT
- ▲ METER
- HOME & FARM BUILDINGS

--- TAX LOT LINE

DIV PT: 257' S AND 325' W OF THE NE CORNER SEC 1
METER: 252' S AND 329' W OF THE NE CORNER SEC 1


CLAIM OF BENEFICIAL USE

Application No. S-86117 Permit No. S-54340

Bruce & Helle Ruddenklau
NW Farm Credit Services

December 10, 2019
SCALE: 1" = 1320'

NOTE: This map is for the purpose of identifying the location of water rights and has no intent to dimension or locate property ownership lines.

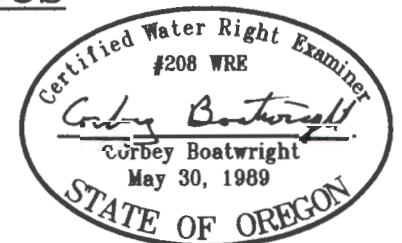

Renews: December 31, 2025