


T.22S. R.09W. SECTION 16

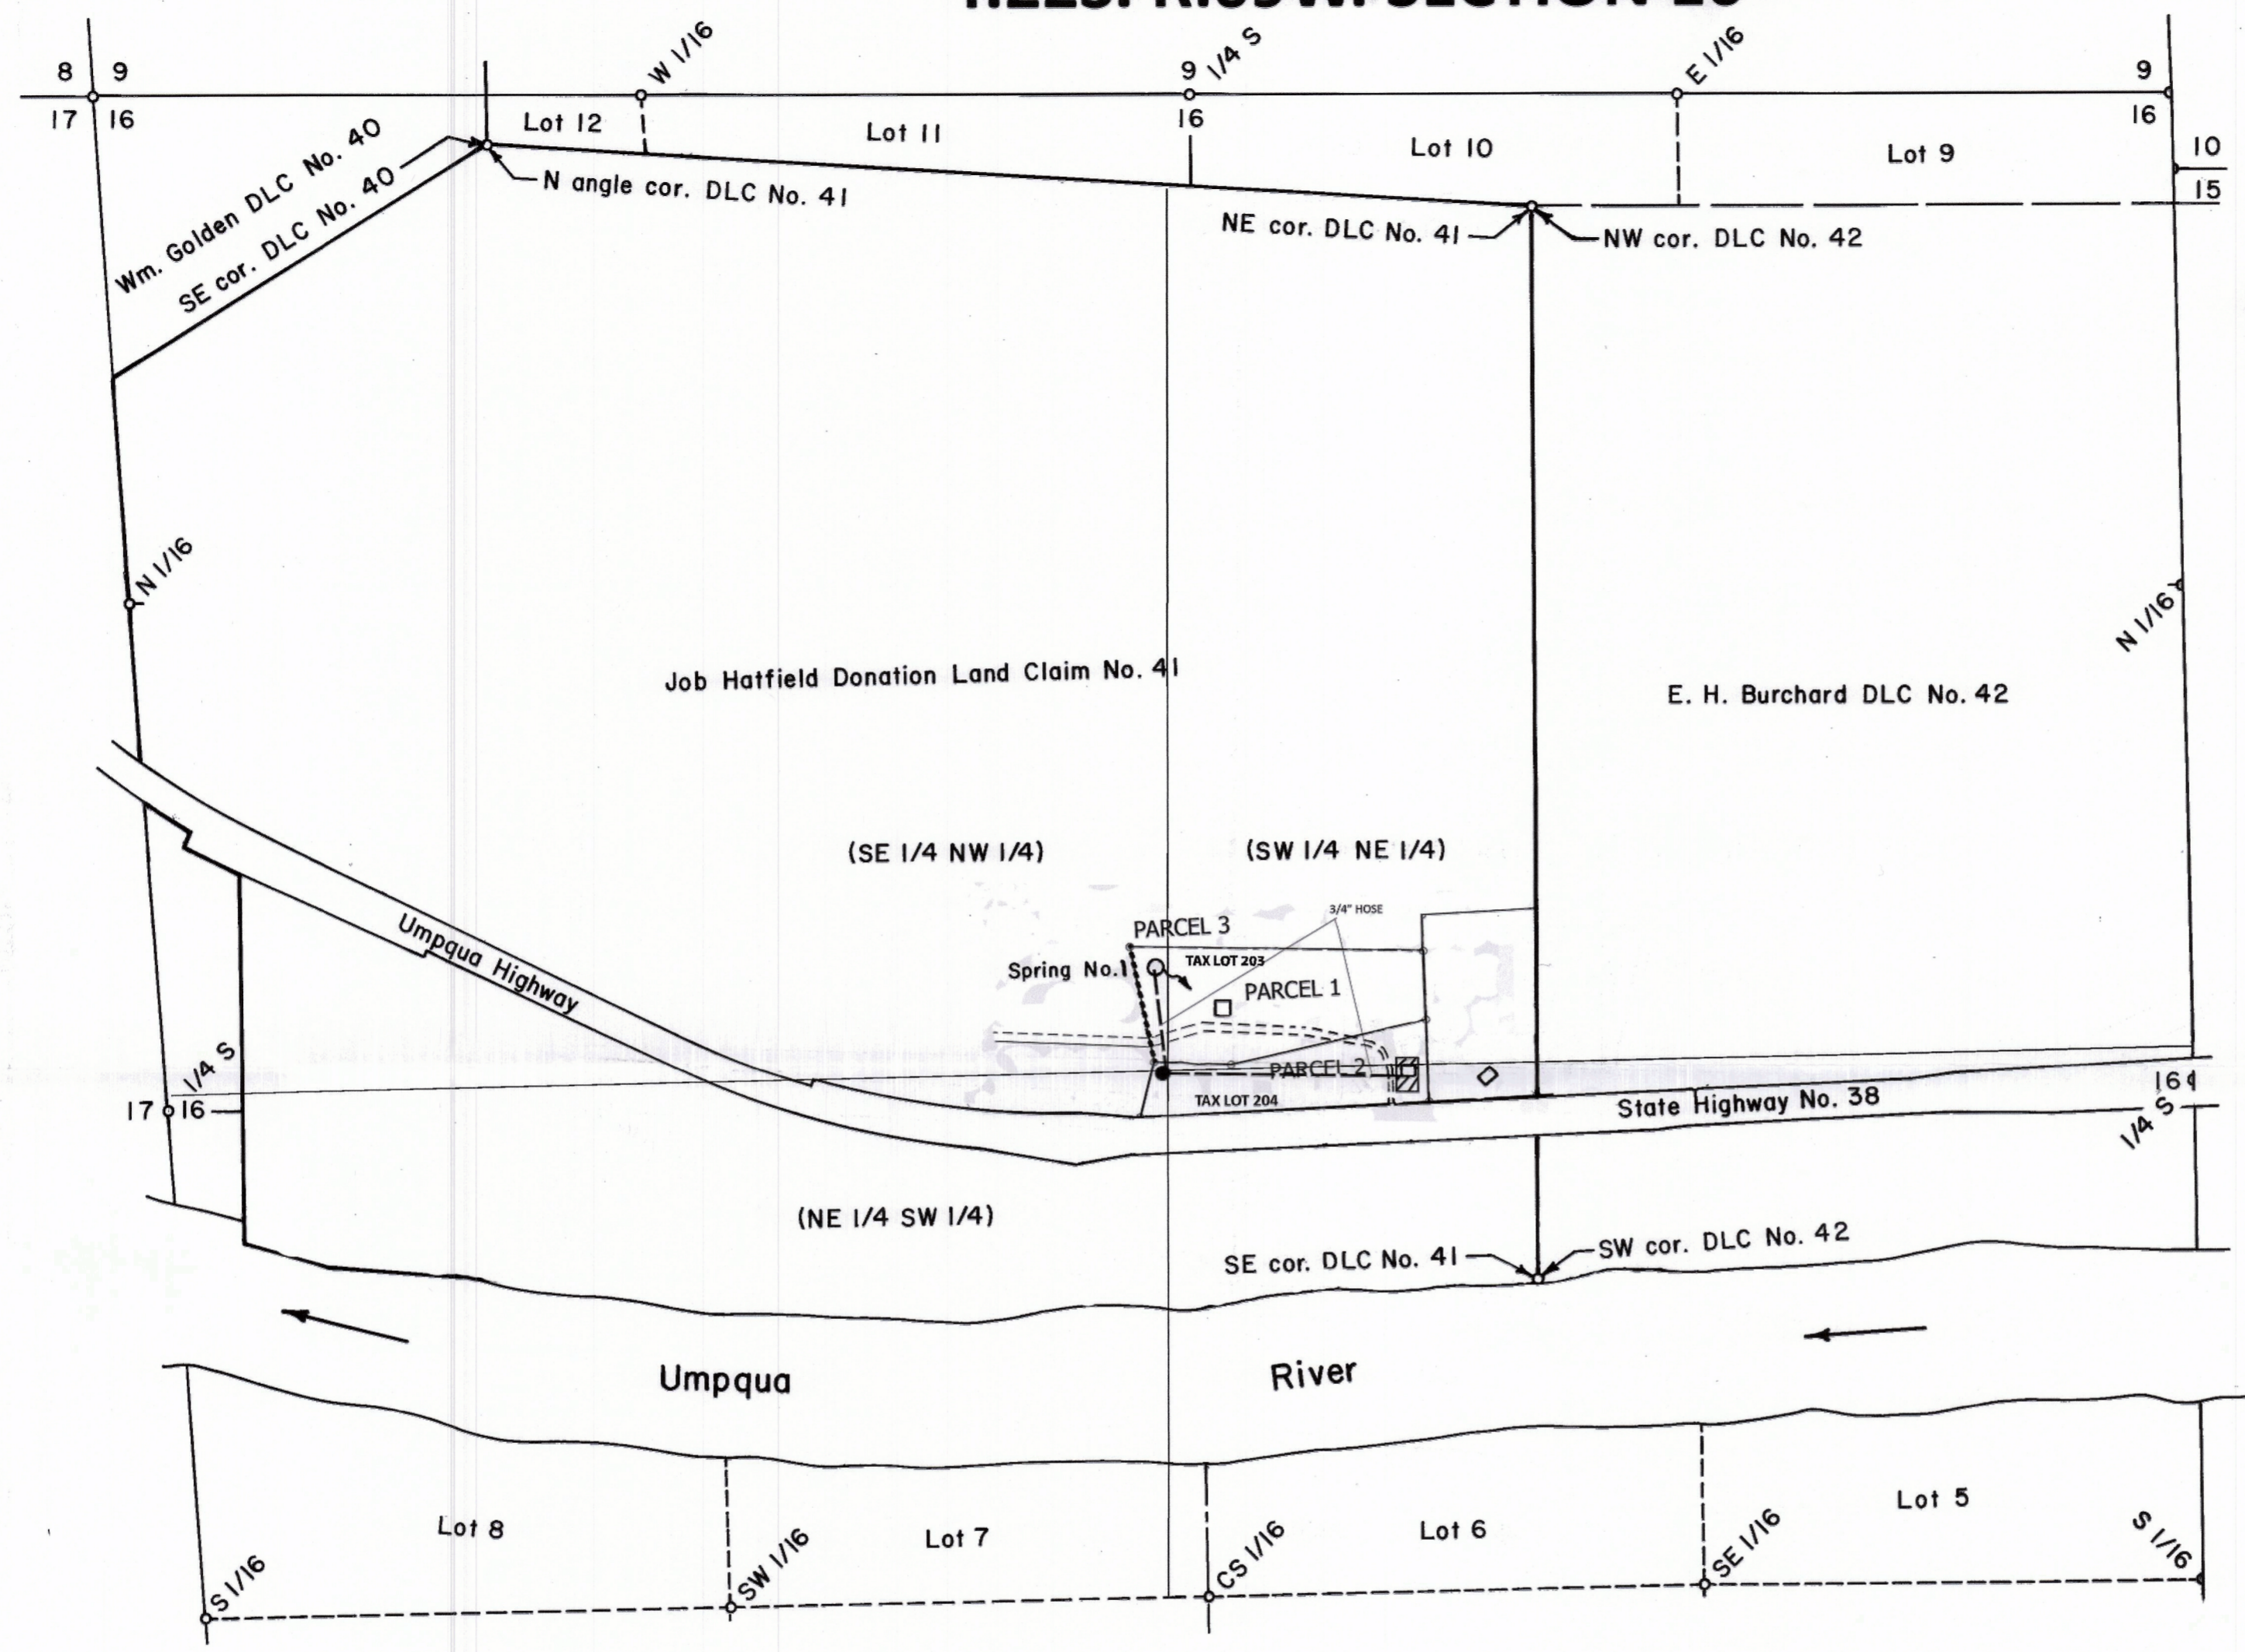

Scale: 1" = 400 ft.



No.	Description	POINTS OF DIVERSION Corner Tie	1/4 1/4 Section	LEGEND
1	*Spring	2,330 ft. South & 120 ft. West of the north 1/4 corner of Section 16	SE 1/4 NW 1/4 Section 16	<ul style="list-style-type: none"> -SPRING -2500 GALLON TANK -ACCESS ROAD -10 FT. WATERLINE EASEMENT - ALONG THE WEST BOUNDRY OF PARCEL 1 IN FAVOR OF PARCEL 2 -SET 5/8" X 30" REBAR WITH A RED PLASTIC CAP MKD. "LS 2865" ○

Received by OWRD
 OCT 31 2024
 Salem, OR

Received by OWRD
 OCT 31 2024
 Salem, OR