

LEGEND

- Point of Diversion (POD)
- Fish Screen
- Meter
- Place of Use (POU)
- Coneynance Line
- South Airport Pond #1
- South Airport Pond #2
- Tax Lot
- Donation Land Claim (DLC)
- Watercourse
- Waterbody

All Other Features

**Claim of Beneficial Use Map
Sarbanand Enterprises, LLC.
Application S-88591; Permit S-55163**


Township 4 South, Range 4 West (W.M.)

Received by OWRD

NOV 04 2024

Salem, OR

CERTIFIED WATER RIGHTS EXAMINER STAMP

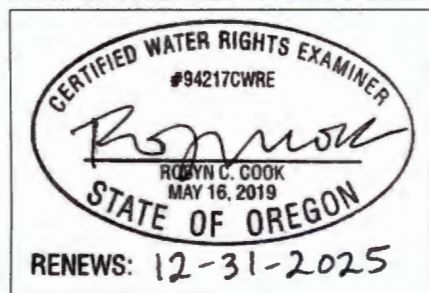

POA LOCATION DESCRIPTION

POD South Airport Pond #1
Located 140 feet South and 2,915 feet West from the NE corner of Section 35, Township 4 South, Range 4 West (W.M.) (-123.146701, 45.185302)

POD South Airport Pond #2
Located 1,500 feet South and 1,425 feet West from the NE corner of Section 35, Township 4 South, Range 4 West (W.M.) (-123.140971, 45.182801)

DISCLAIMER
This map was prepared for the purpose of identifying the location of a water right only and it is not intended to provide legal dimensions or location of property ownership lines.

Date: October 29, 2024
Data Sources: BLM, ESRI, OWRD, USGS

