




**LEGEND**

- Point of Appropriation (POA)
- Meter
- Conveyance Line
- Place of Use (POU)
- Tax Lot
- Donation Land Claim (DLC)
- Watercourse
- Waterbody

**Claim of Beneficial Use Map**  
**Sarbanand Enterprises, LLC.**  
**Application G-18712; Permit G-18744**  
 Township 4 South, Range 4 and 3 West (W.M.)

Received by OWRD  
 NOV 04 2024  
 Salem, OR

**CERTIFIED WATER RIGHTS EXAMINER STAMP**

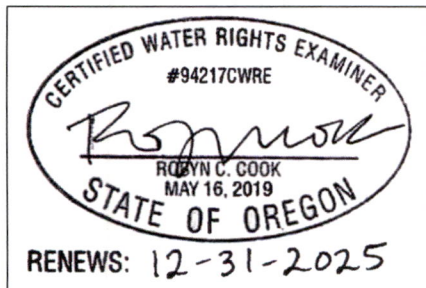

**DISCLAIMER**  
 This map was prepared for the purpose of identifying the location of a water right only and it is not intended to provide legal dimensions or location of property ownership lines.

Date: October 29, 2024  
 Data Sources: BLM, ESRI, OWRD, USGS

**POA LOCATION DESCRIPTION**  
 East Airport Well 2 (YAMH 6833, YAMH 50997)  
 Located 1,635 feet South and 1,325 feet West from the NE corner of Section 25, Township 4 South, Range 4 West (W.M.)  
 (-123.119665669265, 45.1957928715097)

