

Document Path: Y:\0562\_Munger\_Farms\_Sources\_Figures\COBU\COBU\_R88418\_R15272.mxd\_bramos

**LEGEND**

- Point of Diversion (POD)
- Staff Gage
- South Airport Pond #2
- Tax Lot
- Donation Land Claim (DLC)
- Watercourse
- Waterbody


**Claim of Beneficial Use Map  
Sarbanand Enterprises, LLC.  
Application R-88418; Permit R-15272**

Received by OWRD Township 4 South, Range 4 West (W.M.)

NOV 04 2024

Salem, OR

**CERTIFIED WATER RIGHTS EXAMINER STAMP**

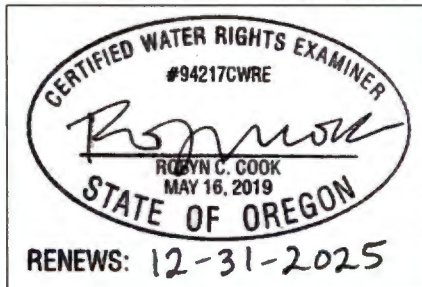

**POD LOCATION DESCRIPTION**  
 Dam Outlet  
 Located 1,150 feet South and 1,570 feet West from the NE corner of Section 35, Township 4 South, Range 4 West (W.M.)  
 (-123.14138637, 45.182641819)

**DISCLAIMER**  
 This map was prepared for the purpose of identifying the location of a water right only and it is not intended to provide legal dimensions or location of property ownership lines.

Date: October 29, 2024  
 Data Sources: BLM, ESRI, OWRD, USGS

