

Document Path: \\s\52-Multipl... Farms\Source-Files\G-18524-017963.mxd, 11/18/2024

**LEGEND**

- Proposed Point of Appropriation (POA)
- Meter
- Proposed Place of Use (POU)
- Conveyance Line
- All Other Features**
- Tax Lot
- Watercourse
- Waterbody

**Claim of Beneficial Use Map  
Sarbanand Enterprises, LLC.  
Application G-18524; Permit G-17963**


Township 5 South, Range 5 West (W.M.)

Received by OWRD

NOV 04 2024

Salem, OR

**CERTIFIED WATER RIGHTS EXAMINER STAMP**

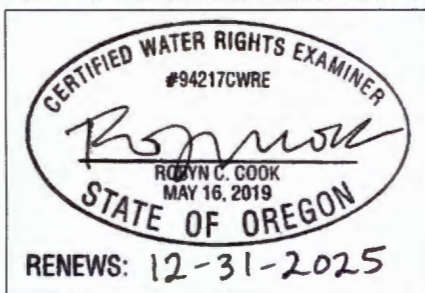

**POA LOCATION DESCRIPTION**

**Point of Appropriation**  
Located 600 feet North and 1,460 feet West from the SE corner of Section 17, Township 5 South, Range 5 West (W.M.) (-123.326071, 45.13168)

**DISCLAIMER**  
This map was prepared for the purpose of identifying the location of a water right only and it is not intended to provide legal dimensions or location of property ownership lines.

Date: September 24, 2024  
Data Sources: BLM, ESRI, OWRD, USGS

