

**LEGEND**

- Point of Diversion (POD)
- Staff Gage
- South Airport Pond #1
- All Other Features**
- Tax Lot
- Watercourse
- Waterbody


**Claim of Beneficial Use Map**  
**Sarbanand Enterprises, LLC.**  
**Application R-88417; Permit R-15271**  
 Township 4 South, Range 4 West (W.M.)

Received by OWRD

NOV 04 2024

Salem, OR

**CERTIFIED WATER RIGHTS EXAMINER STAMP**

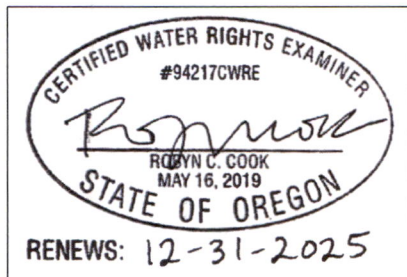

**POA LOCATION DESCRIPTION**

**Dam Outlet**  
 Located 195 feet South and 2,525 feet East from the NW corner of Section 35, Township 4 South, Range 4 West (W.M.)  
 (-123.1465140, 45.1857144)

**DISCLAIMER**  
 This map was prepared for the purpose of identifying the location of a water right only and it is not intended to provide legal dimensions or location of property ownership lines.

Date: October 3, 2024  
 Data Sources: BLM, ESRI, OWRD, USGS

