


R-88400

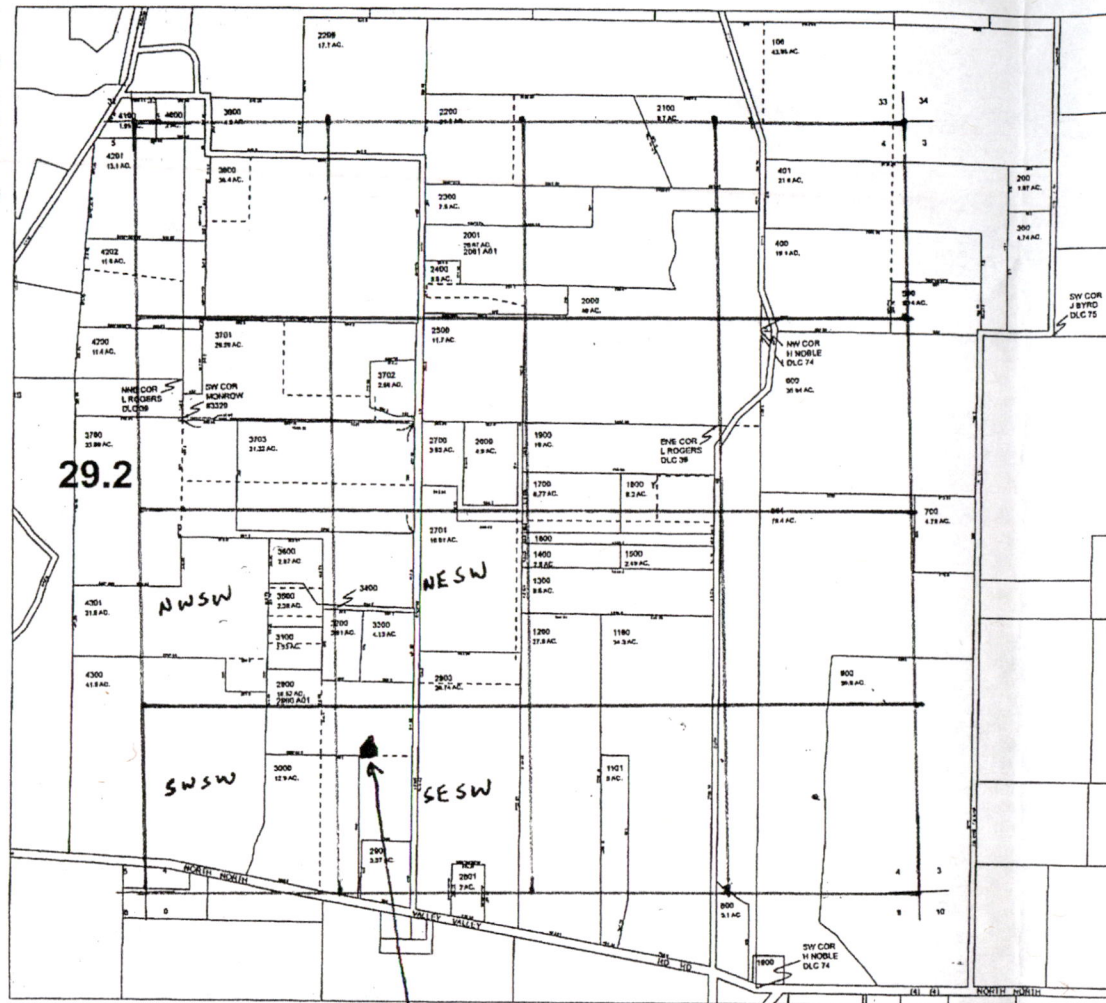

ASSESSMENT & TAX
CARTOGRAPHY

SECTION 4 T.3S. R.3W. W.M.
YAMHILL COUNTY OREGON

3304

RECEIVED BY OWRD

MAR 02 2017

SALEM, OR

North

1" = 1320

CANCELLED TAXLOTS:
3001
1761
2461

DATE PRINTED: 5/11/2016

This product is for Assessment and Taxation (A&T) purposes only
and has not been prepared or modified for legal, engineering,
surveying or any purposes other than assessment and taxation.

3304

R-15235

R-88400

Location: 940' North and 1550' East From SW Corner
Section 4

Received
NOV 04 2024
OWRD