


T. 1 S. R. 10 W. W. M.

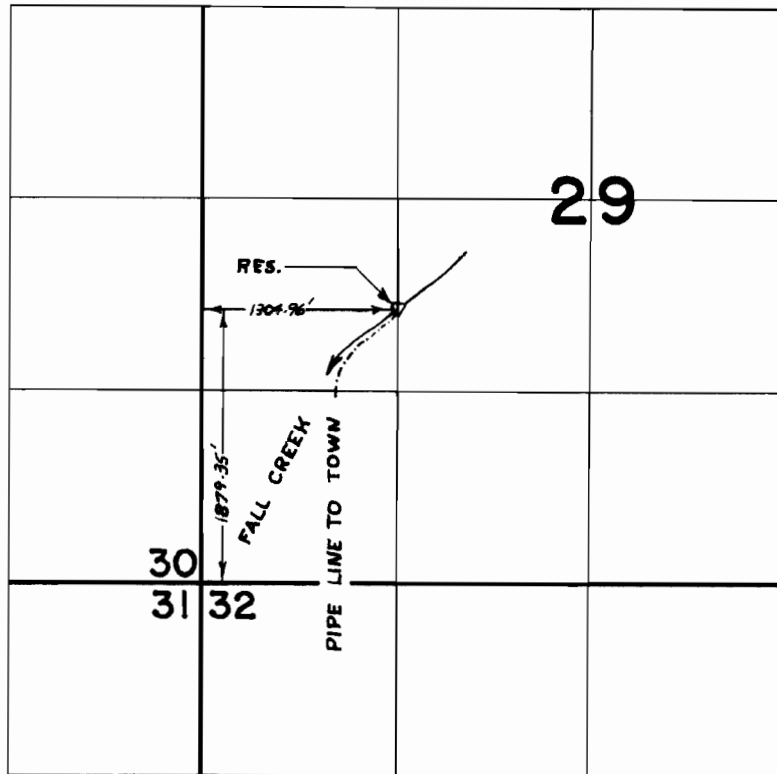

DIV. PT. LOC. FROM APPLICATION MAP

FINAL PROOF SURVEY UNDER

R-38531 R-3213
Application No. 38249... Permit No. 28564....
IN NAME OF

.....NETARTS WATER DISTRICT.....

Surveyed AUG 5, 1971, by R. MUCKEN.....